DRAWING INDEX MEDICAL / DENTAL CLINIC

DWG	DESCRIPTION
0	TITLE SHEET. DWG. INDEX. FOUIP. SCH.
1	USED
2	
3	
4	NOT USED
5	NOT USED
6	NOT USED
7	NOT USED
8	NOT USED
9	BTI FIP
10	SYSTEM ARCHITECTURE / COMM RISER
11	NOT USED
12	AHU1&2 CONTROL DWG (TYPICAL)
13	AHU1 FIP DWG
14	AHU1 I/O SUMMARY & BOM
15	
16	2 1/0 SUMMA
18.0	VAV BOX W/REHEAT COND ALARM & BOM
18.1	BOX W/REHEAT, EXHAUST FAN &
18.2	VAV BOX W/ REHEAT
19	BOILER CONTROL DWG
20	BOILER FIP DWG
21	BOILER I/O SUMMARY & BOM
22	CHILLER CONTROL DWG
23	CHILLER FIP DWG
24	CHILLER I/O SUMMARY & BOM
25	SEQUENCE OF OPERATIONS
26	1
27	
28	
29	
30	
31	
32	
33	
34	

EQUIPMENT SCHEDULE

		, i
_	ı	
1	-	
22	1	CWP 1 &2
19	1	HWP 1 &2
22	***************************************	CHILLER
19	1	BOILER
		- 1
18	-	VAV W/REHEAT
17	1	VAV (COOL ONLY)
i		
12	1	AHU 1 &2
DWG.	PLAN	
222	E 000	
	ב כ ר	

SYMBOLS LEGEND

15	主	1E	1CP	10	1BP	1B	1AP	1 _A	1	C-5	CABLES		4	(E)	₩-	\boxtimes	ISI	Z	+	L-D-JSP1	☐ ☐ CS				\bigcirc	SYMBOLS
(3)#18 AWG, TW/SH, PLENUM	(3)#16 AWG	(2)#16 AWG	(2)#18 AWG, TW/SH, PLENUM	(2)#18 AWG, TW/SH	(3)#18 AWG, PLENUM	(3)#18 AWG	(2)#18 AWG, PLENUM		COMM. TRUNK, (2)#22 AWG TW/SH, PLN	CAT-5			FLOW SWITCH	EXISTING	3-WAY VALVE	MAGNETIC STARTER	GLOBAL CONTROLLER	FIELD MOUNTED CONTROL RELAY	DAMPER ACTUATOR	DUCT STATIC PRESS. TRANS	CURRENT SWITCH	IMMERSION TEMP. SENSOR	DUCT TEMP. SENSOR	CONDENSATE PAN	WALL MOUNTED ALERTON SENSOR	DESCRIPTION


AS-BUILT 07/30/02

REV DATE

ВЧ

PRECISION RESISTOR (100 OHMS 1/4W +/-5% RECOMMENDED) (TYP. FOR ALL) CONNECT AIR # W221P-2554 OR W221P1502 MS/TP CABLE — CAT 5 OR BETTER PATCH CORD/DROP CABLE TO HUB OR SWITCH (250' MAX.) -SEE DWG. 10 FOR MORE INFORMATION SHIELD DRAIN (GROUND AT ONE END END ONLY) \Box EARTH GROUND $\langle O \rangle$ U ANEL 2.75" MIN. MSTP A. MSTP A. MSTP A. MSTP B. MSTP C. MSTP C. MSTP C. MSTP C. MSTP C. MSTP C. PTP E/A-232 (DB-9) ETHERNET 19/100 BASE-T (RJ-45) 06-8φ WIRING [] 8 **E** Sas [] Se TECHNOLOGIES, INC. B FLASHING = NORMAL OPERATION ◆BMCtak: c(T)us REPLACE WITH ALERTON BATTERY PART #: BILBAT-12V REFER TO USERS MANUAL BEFORE SERVICING --- FLASHING = DDC LOADED / OPERATIONAL FOR INDOOR USE ONLY CLASS 2 WIRING DEVICE POWER: MAX LOAD - 10VA USE COPPER CONDUCTORS ONLY ON = DNF LOADED / OPERATIONAL OFF = DNF DOWNLOAD REQUIRED OFF = SERVICE REQUIRED 1月11日記 BTI LAYOUT 余 DEPERATION AC POWER ES O (F (3 #12) 0 24VAC 000 MODEN (OPTIONAL) 12V BATTERY DH FUSE: 1 AMP FAST 5x20mm, 250V GEL CELL BATTERY AND BRACKET MOUNTED WITH MIN. DISTANCE AS SHOWN FOR ACCESS. £ **□** WARNING! DO NOT GROUND EITHER LEG OF SECONDARY TRANSFORMER FS1 Χĭ EARTH 120VAC GROUND 00


BTI-FIP SUBPANEL LAYOUT

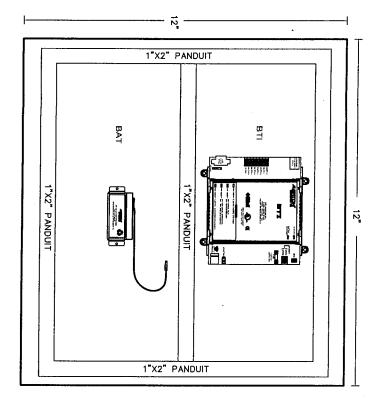



		FIELD - BILI	FIELD - BILL OF MATERIAL (PER BUILDING)	
DEVICE	QTY	PART#	DESCRIPTION	MFR
ВТІ		BTI-MDM	BACTALK INTERGRATOR	ALERTON
ТВ	2	M4/6	TERMINAL BLOCK	KELE
'		M10/16FSL	FUSE HOLDER	KELE
TX1	۔۔	691-KOA	TRANSFORMER, 120/24V, 40VA	KELE
FS1	۔	AGC1	1 AMP GLASS FUSE	BUSS
FIP	٦.	C-SD20208	NEMA 4 ENCLOSURE, 20"x20"x8"	HOFFMAN
	-1	C-P2020	SUBPANEL, 18.2"x18.2"	HOFFMAN
BB	1	•	ELECTRICAL BOX	-

i		REV
		DATE
		ВҮ

AS-BUILT 07/30/02

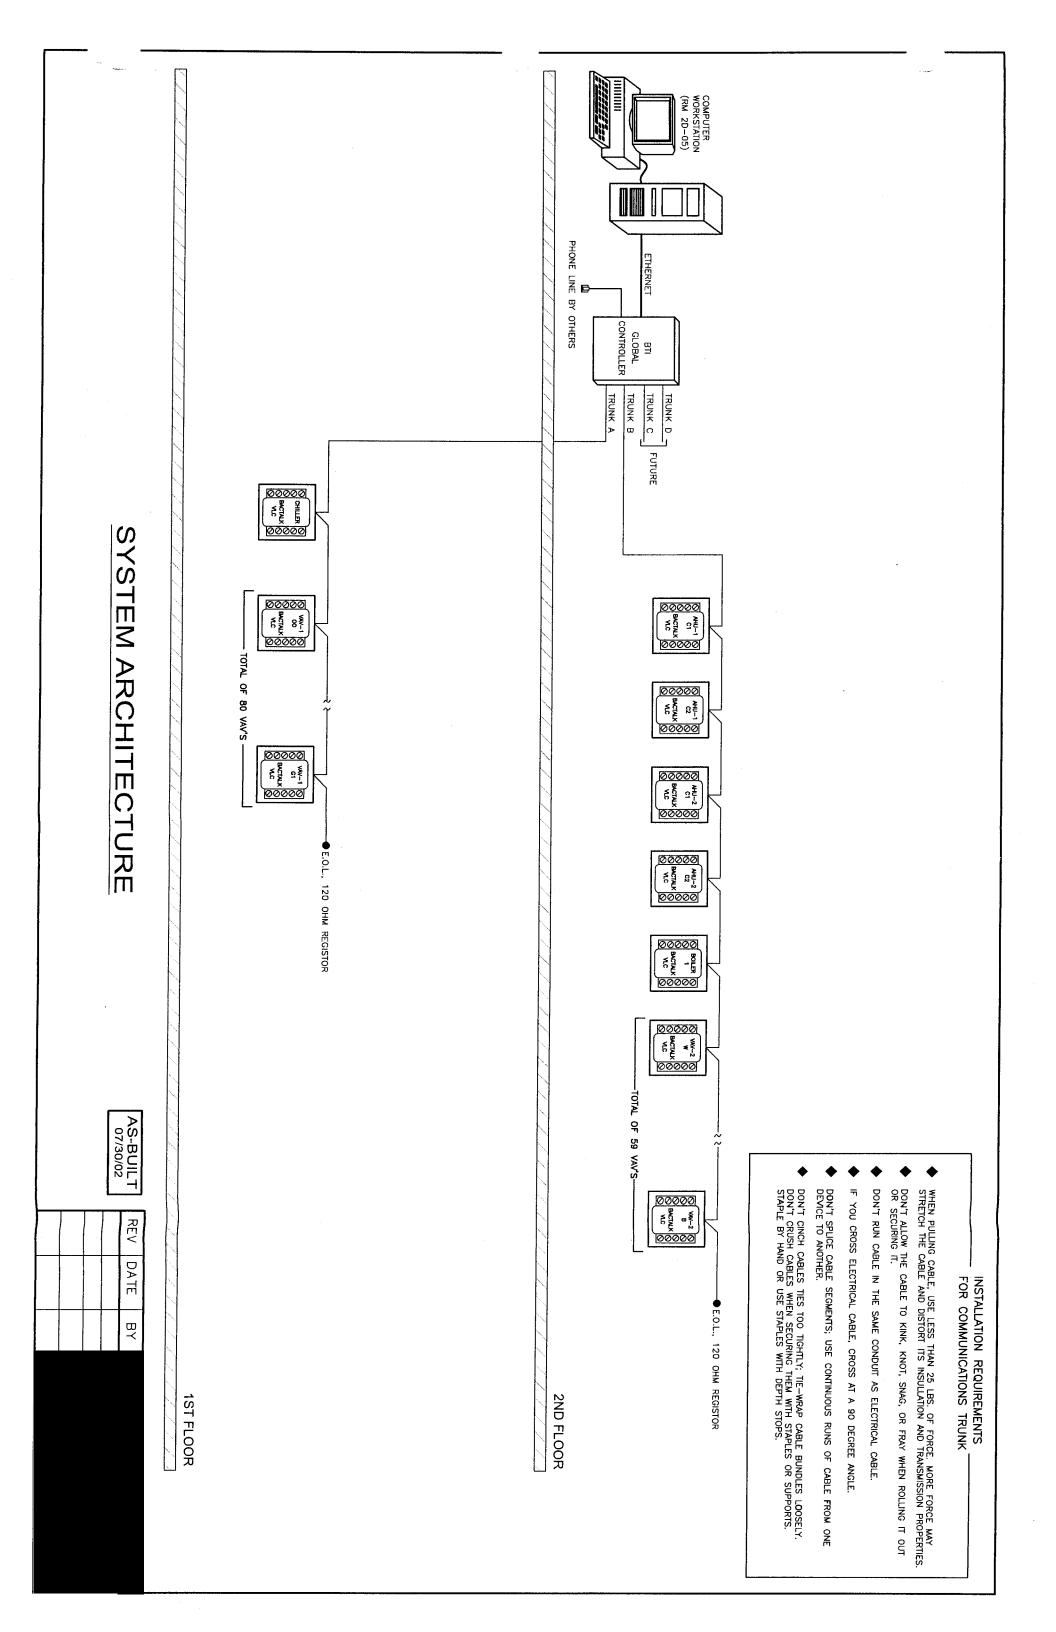

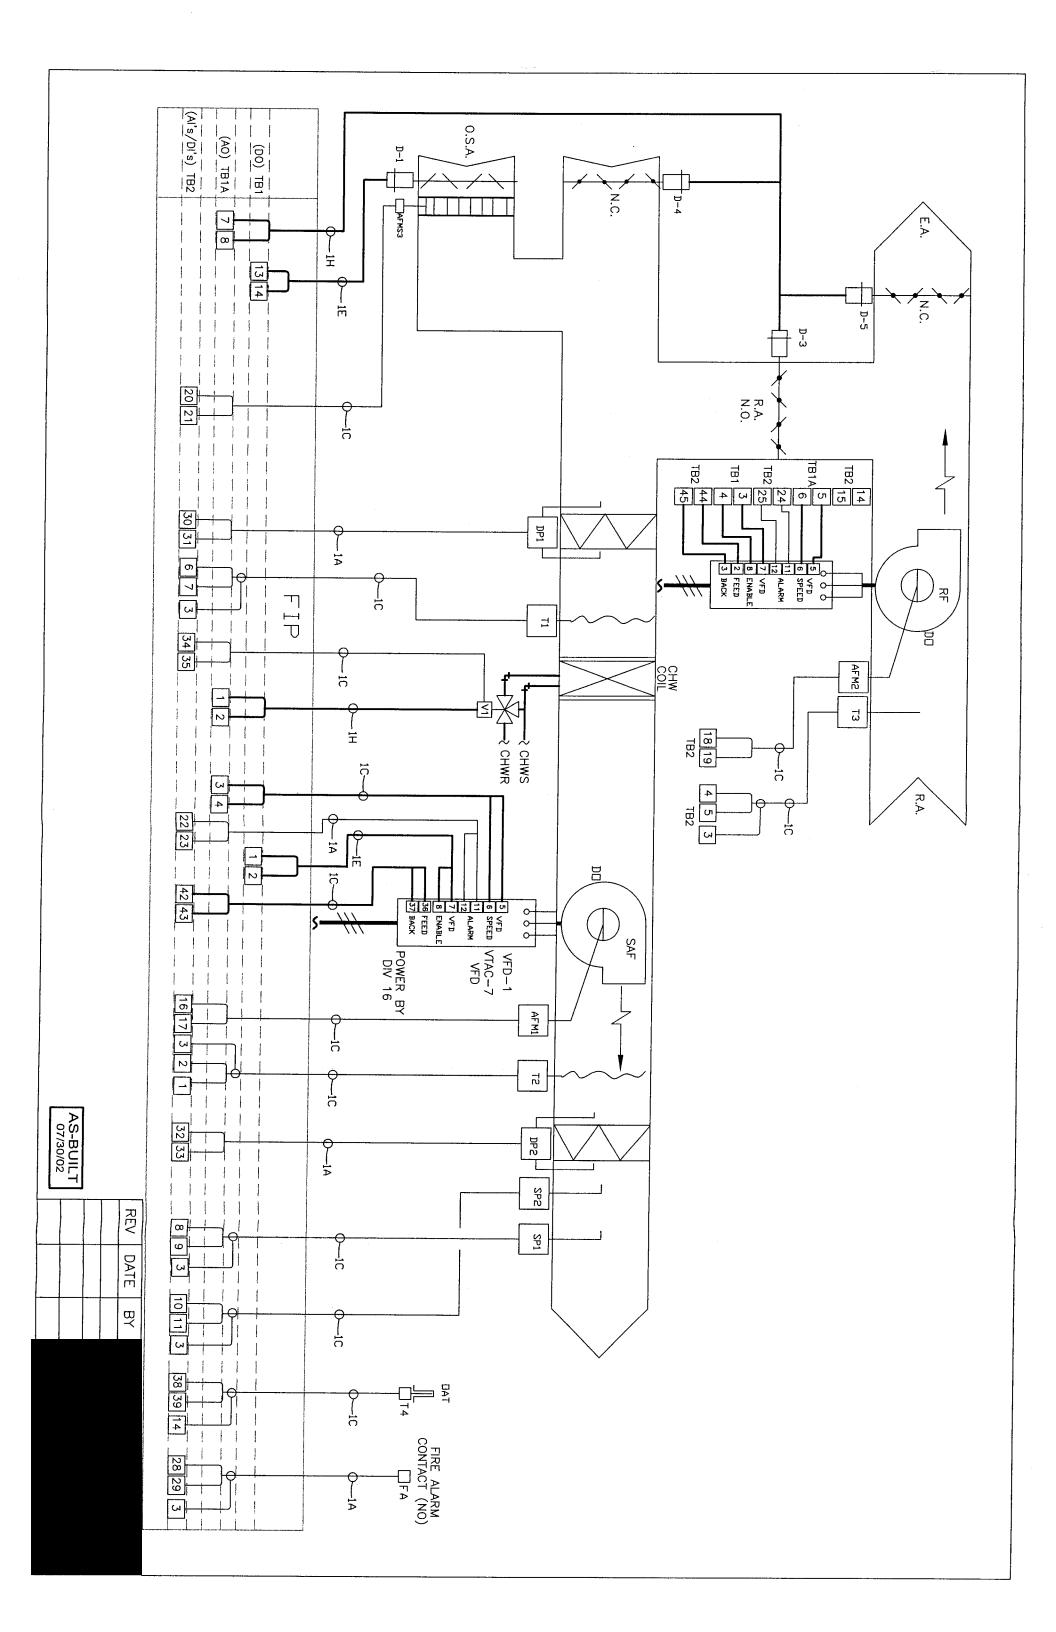

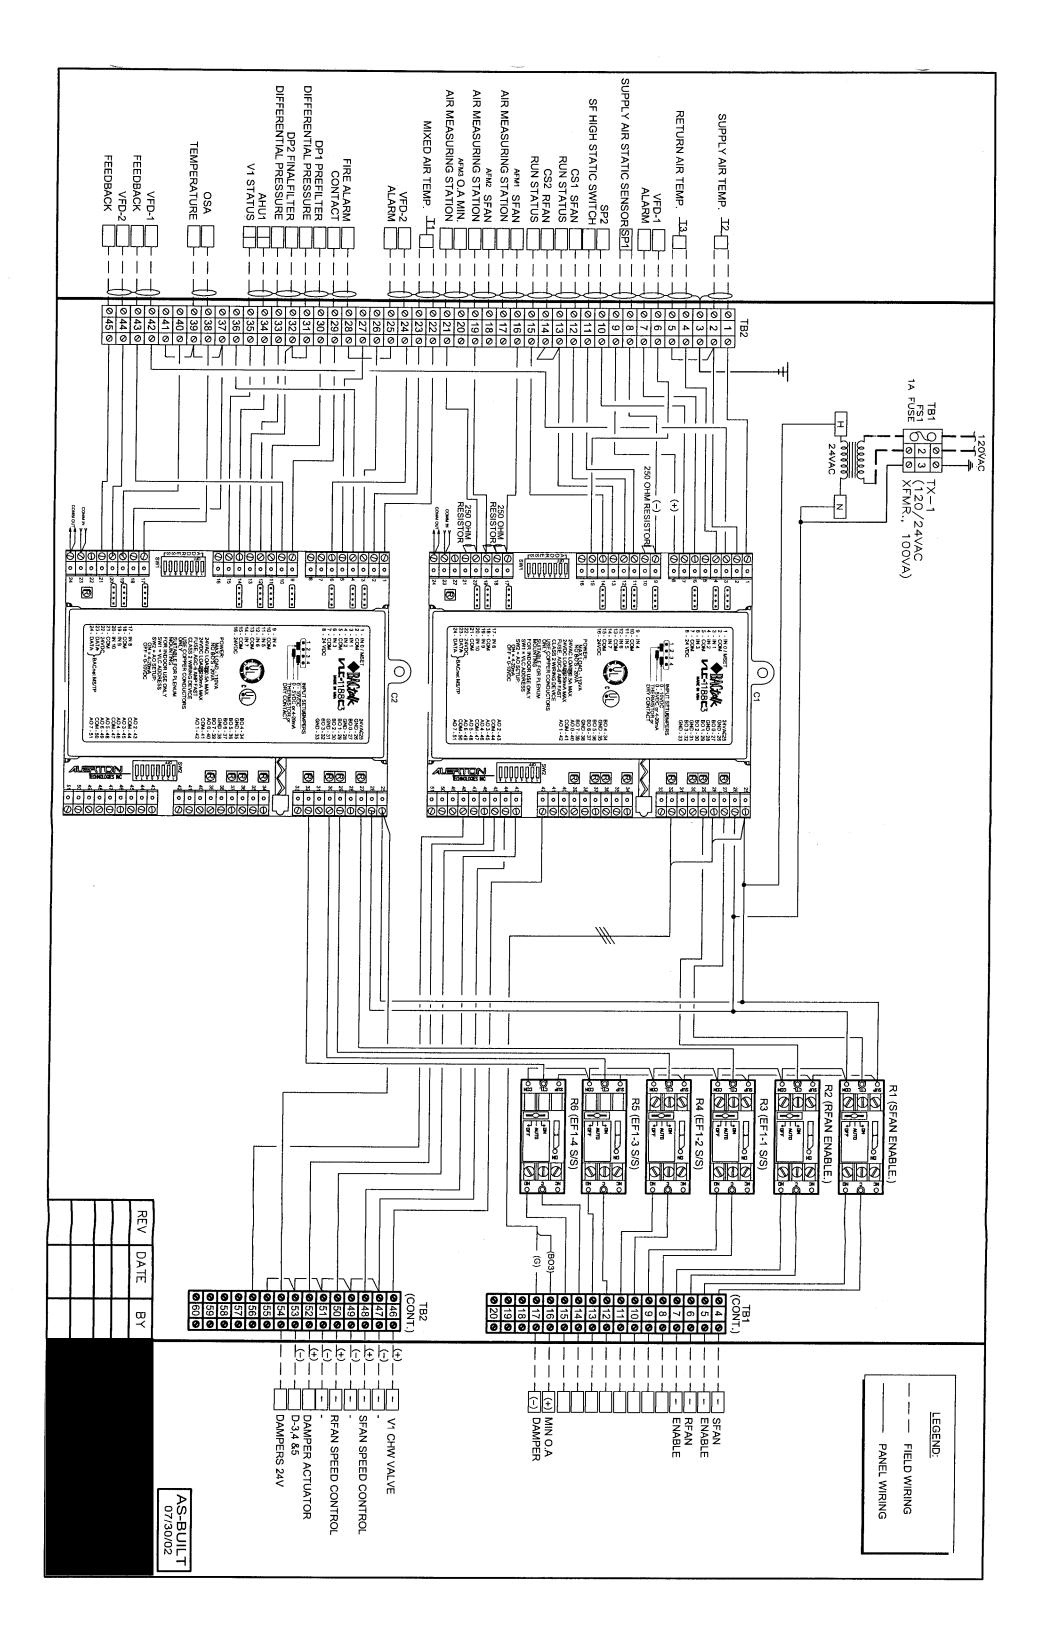

			CO	CONTROLLER SCHEDULE	SCHE	DULE	
col	CONTROLLER:	ER: <i>C1</i>		PE: <i>VLC-11</i>	88C:	ADD	TYPE:VLC-1188C3 ADDRESS: (SEE SCH.
רסכ	LOCATION:	MA	N MEC	MAIN MECH. RM-2D-05	D-05		
SYS	SYSTEM:	AHU-1	1				
Z	TYPE	AUX	P	POINT	TUO	AUX	POINT
0	THERM.	Т2	SUPPLY AIR TEMP	AIR TEMP.	воо	R1	SFAN ENABLE
1	•	VFD-1	FEEDBACK	X	ВО1	R2	RFAN VFD ENABLE
22	THERM.	Т3	RETURN AIR TEMP	AIR TEMP.	B02		
3	D.C.	VFD-1	ALARM		воз	ᄗ	MIN. O.A DAMPER
4	4-20mA	SP1	SUPPLY /	SUPPLY AIR STATIC S.	B04		
5	D.C	SP2	FAN HIGH	FAN HIGH STATIC S.	B05		
9	D.C	CS1	SFAN STATUS	\TUS	B06		
7	D.C	CS2	RFAN STATUS	ATUS	A01	٧1	CHILLED WATER VALVE
8	4-20mA	AFM1	AIR FLOW SFAN	/ SFAN	A02	VFD	SFAN SPEED CONTROL
9	4-20mA	AFM2	AIR FLOW RFAN	/ RFAN	403	VFD	RFAN SPEED CONTROL
10	4-20mA	AFM3	MIN O.A. FLOW	-LOW	A04	D3,4&5	DAMPER ACTUATORS
					A05		
					A06		
					A07		

CONTROLLER SCHEDULE
ONTROLLER: C^2 TYPE: $VLC-1188C3$ ADDRESS: $(SEE\ SCH.)$
OCATION: MAIN MECH. RM-2D-05
STEM: AUIT 4

핕 FS2

A-24N24ALP A-24N24MP

NEMA 1 ENCLOSURE, 24"WX24"Hx6"D SUBPANEL, 21.00"HX22.50"W

HOFFMAN

HOFFMAN


E

4 AMP.

GLASS FUSE

CON	CONTROLLER:		C2	TYPE:	TC-11	88C3	ADDI	TYPE:VLC-1188C3 ADDRESS: (SEE SCH.)
LOC,	LOCATION:	MA	W VI	ECH.	MAIN MECH. RM-2D-05	D-05	- 1	
SYS	SYSTEM: AHU-1	HU-1	,					
ž	TYPE	AUX		POINT	T	TUO	AUX	POINT
0	THERM.	그	MIXE	MIXED AIR TEMP	ďΡ	ВОО		
1						B01		7 - 1 - 1 - 1 - 1 - 1 - 1 - 1 - 1 - 1 -
22						B02		
ω.	D.C	VFD-2	ALARM	S		воз		
4	D.C	FA	FIRE	FIRE ALARM		B04		
5	D.C	PP1	PREF	PRE FILTER		B05		
6	D.C	DP2	FINAL	FINAL FILTER		B06		
7	,	5	CHW	CHW VALVE POSITION	NOITISC	A01		
80	THERM.	T4	OSA 7	OSA TEMPERATURE	TURE	A02		
9						A03		
10	•	VFD-2	FEEDBACK	BACK		A04		
						405		
						A06		
						A07		

DEVICE QUANTITY PART# DESCRIPTION DESCRIPTION					
QUANTITY PART# DESCRIPTION 3 2841-005WD-11-TI-C 0-5" STATIC PRESSURE TRANSDUCER S 1 1900-5-MR COMPACT LOW DIFFERENTIAL SWITCH D 2 ST-FZ3-25 25" AVER. DUCT TEMP. SENSOR K 1 TS-2008BT 8" DUCT TEMP. SENSOR K 6 1910 DIFF. PRESSURE SWITCH ACCESSORY D 6 A-602 DIFF. PRESSURE SWITCH ACCESSORY D 1 SEE.VALVE.SCHEDULE 3-WAY VALVE DIVERTING VALVE D 2 I/DP-8-4 DUCT TRANS. 4-20mA, 0-3" IF 6 A-302 SP TIP. BARB CONN. D 6 A-302 SP TIP. BARB CONN. D 6 A-345 SP TIP. BARB CONN. D 3 - DAMPER ACTUATORS IF QUANTITY PART# DESCRIPTION A 4 B9-K1 120/24VAC XFMR., 100VA K 85 M466 END STOPS K 86 M10/16SFL FUSE WHOLDER			+ iE	3 - BILL OF MATERIALS	
3 2641-005WD-11-TI-C 0-5" STATIC PRESSURE TRANSDUCER 1 1900-5-MR COMPACT LOW DIFFERENTIAL SWITCH D 25" AVER. DUCT TEMP. SENSOR N TS-2008BT 8" DUCT TEMP. SENSOR N TS-2008BT 8" DUCT TEMP. SENSOR N TS-2008BT	DEVICE	QUANTITY	PART#	DESCRIPTION	MANUFACTURER
1 1900-5-MR COMPACT LOW DIFFERENTIAL SWITCH D 2 ST-FZ3-25 25' AVER, DUCT TEMP, SENSOR N TS-2008BT 8" DUCT TEMP, SENSOR N TS-2008BT 8" DUCT TEMP, SENSOR N TS-2008BT 8" DUCT TEMP, SENSOR N TS-2008BT N	AFM/TRANS	3	2641-005WD-11-TI-C	0-5" STATIC PRESSURE TRANSDUCER	SETRA
2 ST-F23-25 25' AVER. DUCT TEMP. SENSOR 1 1 TS-2008BT 8" DUCT TEMP. SENSOR 6 2 H7708 CURRENT SENSOR 9 6 1910 DIFFERENTIAL PRESSURE SWITCH 6 6 A-602 DIFF. PRESSURE SWITCH ACCESSORY 1 1 SEE. VALVE. SCHEDULE 3-WAY VALVE. DIVERTING VALVE 9 2 I/IDP-8-4 DUCT TRANS. 4-20mA, 0-3" IF 6 2 I/IDP-8-4 DUCT TRANS. 4-20mA, 0-3" IF 6 3	SP2	1	1900-5-MR	COMPACT LOW DIFFERENTIAL SWITCH	DWYER
1 TS-2008BT 8" DUCT TEMP. SENSOR A 2 H708 CURRENT SENSOR A 6 1910 DIFFERENTIAL PRESSURE SWITCH DIFF. PRESSURE SWITCH ACCESSORY 6 A-602 DIFF. PRESSURE SWITCH ACCESSORY 1 SEE. VALVE. SCHEDULE 3-WAY VALVE DIVERTING VALVE B 2 I/IDP-84 DUCT TRANS. 4-20mA, 0-3" IF 6 A-302 SP TIP. BARB CONN. 6 A-345 SP TIP. BARB CONN. DAMPER ACTUATORS 3	T1/T2	2	ST-FZ3-25	25' AVER. DUCT TEMP. SENSOR	KELE
2	Т3	_	TS-2008BT	8" DUCT TEMP. SENSOR	ALERTON
1910 DIFFERENTIAL PRESSURE SWITCH D	CS1,CS2	2	H708	CURRENT SENSOR	HAWKEYE
6 A-602 DIFF. PRESSURE SWITCH ACCESSORY D	DP1/DP2	6	1910	DIFFERENTIAL PRESSURE SWITCH	DWYER
1 SEE.VALVE.SCHEDULE 3-WAY VALVE.DIVERTING VALVE B 2 I/DP-8.4 DUCT TRANS. 4-20mA, 0-3* I/OP-8.4 6 A-302 SP TIP.BARB CONN. I/O 6 A-302 SP TIP.BARB CONN. I/O 6 A-345 SP TIP.BARB CONN. I/O 7 SP TIP.BARB CONN. I/O 7 DAMPER ACTUATORS 7 DAMPER ACTUATORS 7 DESCRIPTION I/O 7 PART# DESCRIPTION I/O 7 PART# CONTROLLER I/O 7 VLC-1188C3 CONTROLLER I/O 7 PART# CONTROLLER I/O 8 BAM R-601T RELAY WIHOA SWITCH I/O 8 BAM FEM6 END SECTION I/O 8 BAM FEM6 END SECTION I/O 8 BAM FEM6 END STOPS I/O 8 BAM FUSE WIHOLDER I/O 8 KAND FUSE WIHOLDER I/O 8	,	6	A-602	DIFF. PRESSURE SWITCH ACCESSORY	DWYER
2 I/DP-84 DUCT TRANS. 4-20mA, 0-3" IF 6	<u>~1</u>		SEE.VALVE.SCHEDULE	3-WAY VALVE DIVERTING VALVE	BELIMO
6 A-302 SP TIP.BARB CONN. D	SP1	2	I/DP-8-4	DUCT TRANS. 4-20mA, 0-3"	INTEC
6 A-345 SPTIP FLANGE DAMPER ACTUATORS	•	6	A-302	SP TIP.BARB CONN.	DWYER
SUBPANEL - BILL OF MATERIALS		6	A-345	SP TIP FLANGE	DWYER
SUBPANEL - BILL OF MATERIALS	D3,4&5	3		DAMPER ACTUATORS	•
SUBPANEL - BILL OF MATERIALS					
DESCRIPTION DESCRIPTION DESCRIPTION			SUBPAN	NEL - BILL OF MATERIALS	
C2 2 VLC-1188C3 CONTROLLER 1 1 691-K1 120/24VAC XFMR., 100VA R6 6 MR-601T RELAY W/HOA SWITCH LTB3 85 M4/6 TERMINAL BLOCK 8 FEM6 END SECTION 8 BAM END STOPS 2 M10/16SFL FUSE W/HOLDER 1 AGC 1 1 AMP. GLASS FUSE	DEVICE	QUANTITY	PART#	DESCRIPTION	MANUFACTURER
1 1 691-K1 120/24VAC XFMR., 100VA R6 6 MR-601T RELAY WHOA SWITCH LTB3 85 M4/6 TERMINAL BLOCK 8 FEM6 END SECTION 8 BAM END STOPS 2 M10/16SFL FUSE WHOLDER 1 AGC 1 1 AMP. GLASS FUSE	C1/C2	2	VLC-1188C3	CONTROLLER	ALERTON
R6	TX-1	<u> </u>	601_K1	120/24/10 15/10 100/10	
1 AGC 1 1 AMP. GLASS FUSE	R1-R6	. a	MR-601T	BELIAY WATCH SWITCH	RELE
8 FEM6 END SECTION 8 BAM END STOPS 2 M10/16SFL FUSE W/HOLDER 1 AGC 1 1 AMP. GLASS FUSE	ТВО-ТВЗ	85	M4/6	TERMINAL BLOCK	7000
8 BAM END STOPS 2 M10/16SFL FUSE W/HOLDER 1 AGC 1 1 AMP. GLASS FUSE		00	EEMS	END SECTION	ָרָבְּיִבְּיִבְּיִבְּיִבְּיִבְּיִבְּיִבְּיִ
2 M10/16SFL FUSE W/HOLDER 1 AGC 1 1 AMP. GLASS FUSE		8	BAM	END STOPS	יינים די
1 AGC 1 1 AMP. GLASS FUSE		2	M10/16SFL	FUSE W/HOLDER	XELE.
	FS1		AGC 1	1 AMP. GLASS FUSE	KELE

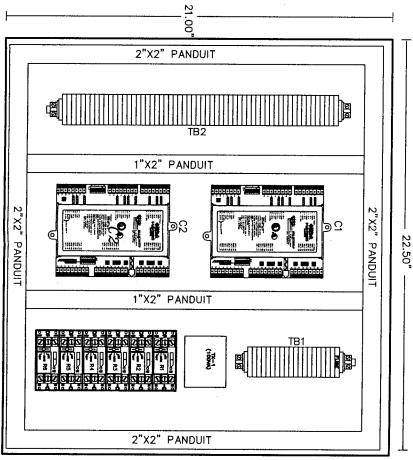

┙ AHU-1 SUBPANEL LAYOUT

SEQUENCE OF OPERATIONS

When the outside air temperature drops below 11.4°C (52.5°F) the cooling coil control valve (V-1) shall be closed to the cooling coil and economizer, relief and return dampers (D-3, D-4, & D-5) shall modulate in sequence to maintain the discharge air temperature 11.4°C (52.5°F) two duct mounted static pressure sensors/controllers shall modulate the variable frequency drives mounted near the AHU, through a discriminator selector, to maintain a min.static pressure of 250Pa (1" wg) setpoint. The return air fan shall track the operation of supply air fan by maintaining a constant differential airflow equal to that of the min. outside air. Supply and return airflow-measuring stations mounted in the fan inlet/s shall measure airflow's. A high static pressure sensor shall shut down both supply and return airflow-measuring stations mounted in the fan inlet/s shall measure airflow's. A high static pressure sensor shall shut down both supply economizer at valve (V-1) sl When the outside air temperature is below 21°C (70°F), the min OA damper (D-1) shall be open, return air, economizer and relief air dampers (D-3, D-4 AND D-5) shall modulate in sequence with the cooling coil control (V-1) to maintain discharge air 21°C (70°F) 1 dampers (D-2 AHU-1& 2

When the system is in operation as indicated the following sequence shall occur. The minimum out side airflow shall be measured through a duct-mounted airflow measuring minimum out side airflow shall be measured through a further than outside air temperature is at or above and return air fan drives when the duct pressurizes 1250Pa (5" wg). This controller shall be directly connected to the VFD drives and alarm the DDC system on the high static pressure shut emperature setpoint of 11.4°C (52.5°F) and the min. outside airflow shall be maintained. 2 & D-3) shall modulate to maintain the minimum outside airflow, the and relief air dampers (D-4 & D-5) shall be closed and cooling coil control the minimum outside air damper (D-1) shall open, the return air and relief air hall modulate to maintain the discharge temperature at 11. 4°C (52.5°F)

BUILDING COOL DOWN CYCLE (COOLING PERIOD ONLY)
Approximately 1-1/2 hours before the normal time occupancy of the building occurs, the DDC system shall start the HVAC system as follows: the return damper shall open, the AHU supply fans shall start, all interlocked exhaust fans shall remain off, CWP-1 and CWP-2 shall start and chiller WCI-1 shall operate when water flow is proven. All chilled water control valves for AHU cooling coil shall make to the water shall start and chilled water control valves for AHU cooling coil shall make to the water shall start and chilled water control valves for AHU cooling coil shall make to the water shall start and chilled water control valves for AHU cooling coil shall make the water shall start and chilled water control valves for AHU cooling coil shall when water flow is proven. All chilled water control valves for AHU cooling coil shall modulate to maintain their set point temperature. During this period of operation the outside damper shall remain closed. Approximately ½ hour before the normal occupancy period occurs the DDC system shall place the system in the normal occupied position, the outside damper shall open, interlocked exhaust fans shall start and the AHU system and cooling system shall continue to operate in their normal occupied sequence.

Approximate!
Approximate!
place the syste
interlocked ex BUILDING WARM-UP CYCLE (HEATING PERIOD ONLY)
Approximately 1-1/2 hours before the normal time occupa
DDC system shall start the HVAC system as follows: the
AHU supply fans shall start, all interlocked exhaust fans s continue to operate in their normal occupied sequence. start, and the boiler B-1 shall be enabled when then water flow is proven. All H.W. control valves for terminal unit coils shall modulate to maintain their occupied set point stem in the normal occupied position, the outside air damper shall open, exhaust fans shall start and the AHU systems and the heating systems shall ly 1/2 hour before the normal occupancy period occurs the DDC system shall During this period of operation the outside air damper shall remain closed. shall start the HVAC system as follows: the return damper shall open, the fans shall start, all interlocked exhaust fans shall remain off, HWP-1 shall ly 1-1/2 hours before the normal time occupancy of the building occurs, the

TIMED OVERRIDE CYCLE


Each terminal unit thermostat (TU T-STAT) shall be capable of overriding the system "OFF" cycle to provide periods of system override operation. The TU STAT shall override the operation of the DDC system "OFF" period, when the DDC system has the system off for unoccupied periods. The TU STAT shall have the capability to operate for a maximum period of 4 hours (adjustable from the central processor). When the TU STAT is manually set the associated AHU shall start in its normal sequence, and the reating and /or cooling systems shall start and operate in its normal operating sequence. When the TU STAT has expired the AHU and heating and/or cooling systems shall stop aually set the associated AHU shall start in its normal sequence, and the the normal unoccupied sequence. STAT has expired the AHU and heating and/or cooling systems shall stop

REV

DATE

ΒY

AS-BUILT 07/30/02

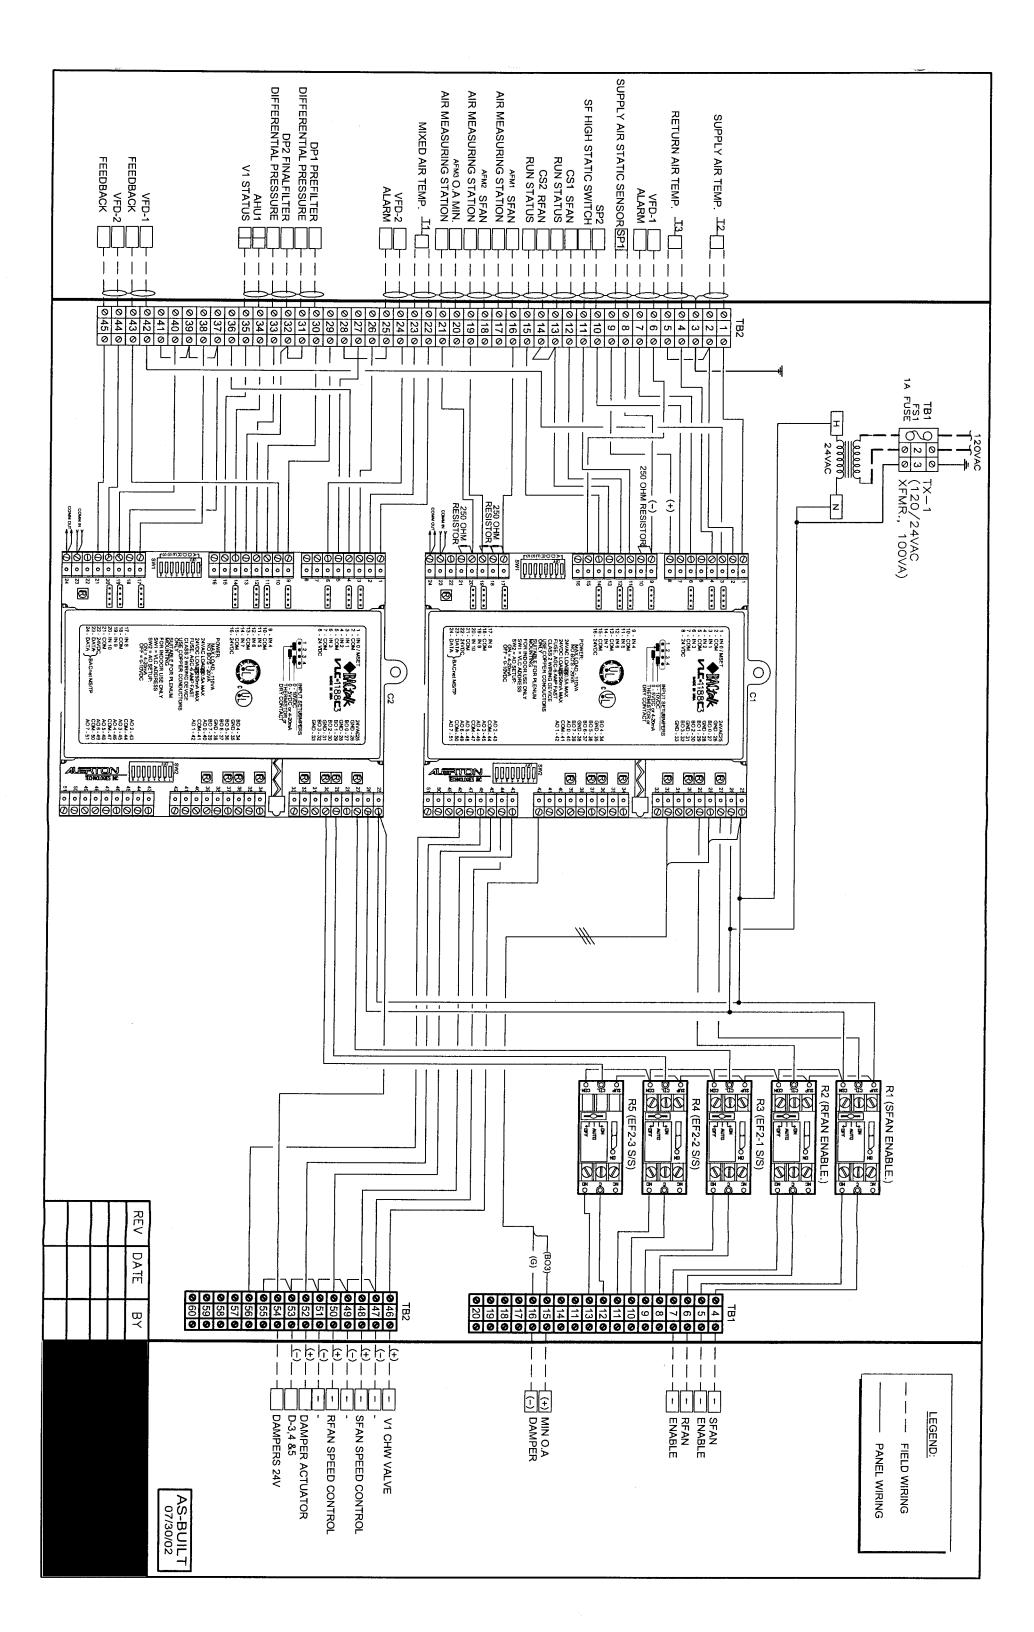

		407				
		406				
		405				
DAMPER ACTUATORS	D3,4&5	404	MIN O.A. FLOW	AFM3 I	4-20mA	10
RFAN SPEED CONTROL	VFD	403	AIR FLOW RFAN	AFM2 /	4-20mA	9
SFAN SPEED CONTROL	VFD	A02	AIR FLOW SFAN	AFM1 /	4-20mA	8
CHILLED WATER VALVE	5	A01	RFAN STATUS	CS2 F	D.C	7
		B06	SFAN STATUS	CS1	D.C	9
		B05	FAN HIGH STATIC S.	SP2	D.C	5
		B04	SUPPLY AIR STATIC S.	SP1	4-20mA	4
MIN. O.A DAMPER	D1	воз	ALARM	VFD-1	D.C.	w
		B02	RETURN AIR TEMP.	73	THERM.	2
RFAN VFD ENABLE	R2	B01	FEEDBACK	VFD-1 F	•	1
SFAN ENABLE	R1	Воо	SUPPLY AIR TEMP.	T2	THERM.	0
POINT	AUX	ОUТ	POINT	AUX	TYPE	Ē
			2	AHU-2	SYSTEM:	SYS
	_,	D-05	MAIN MECH. RM-2D-05	MAI	LOCATION:	Г
TYPE:VLC-1188C3 ADDRESS: (SEE SCH.)	ADD	88C3		ER: <i>C1</i>	CONTROLLER:	င္ပ
	DULE	SCHE	CONTROLLER SCHEDULE			
						1

D3,4&5

A-345 A-302 I/DP-8-4

DAMPER ACTUATOR SP TIP FLANGE

DESCRIPTION

ALERTON

100VA

SP TIP.BARB CONN.

INTEC DWYER DWYER

DUCT TRANS. 4-20mA, 0-3"

DP1/DP2 2S1,CS2

1910 H708

TS-2008BT ST-FZ3-25 1900-5-MR

25' AVER, DUCT TEMP, SENSOR

CURRENT SENSOR 8' DUCT TEMP, SENSOR O-5" STATIC PRESSURE TRANSDUCER

DESCRIPTION

COMPACT LOW DIFFERENTIAL SWITCH

SETRA DWYER KELE

ALERTON

FIELD - BILL OF MATERIALS

A-602 SEE.VALVE.SCHEDULE

DIFFERENTIAL PRESSURE SWITCH
DIFF. PRESSURE SWITCH ACCESSORY
3-WAY VALVE DIVERTING VALVE

HAWKEYE DWYER DWYER BELIMO

0 7 0	200			C1/C2	2	VLC-1188C3	CONTROLLER
N STATUS	401	<u> </u>	CHILLED WATER VALVE				
		- 1		TX-1	_	691-K1	120/24VAC XFMR., 100
FLOW SHAN	AUZ	ž	SHAN SPEED CONTROL	R1-R5	5	MR-601T	RELAY W/HOA SWITCH
FLOW RFAN	403	٧FD	RFAN SPEED CONTROL	Тво-твз	85	M4/6	TERMINAL BLOCK
		3			8	FEM6	END SECTION
O.A. FLOW	A04	D3,4&5	AUA D3,4&5 DAMPER ACTUATORS		8	BAM	END STOPS
	405				2	M10/16SFL	FUSE W/HOLDER
				FS1	1	AGC 1	1 AMP. GLASS FUSE
	A06			FS2	-	AGC.5	4 AMP. GLASS FUSE
	407						
				F	-	A-24N24ALP	NEMA 1 ENCLOSURE,
				-	1	A-24N24MP	SUBPANEL, 21.00"HX2
	İ			•			
CONTROLLER SCHEDULE	SCHE	JULE					

S"YS" DANDET	22.50"		
			-

NEL, 21.00"HX22.50"W ENCLOSURE

HOFFMAN HOFFMAN

24"WX24"Hx6"D

SYSTEM: AHU-2

AUX

AUX

POINT

THERM. TYPE

그


MIXED

AIR TEMP POINT LOCATION: CONTROLLER:

MAINC2

MECH. RM-2D-05

TYPE:VLC-1188C3 ADDRESS: (SEE SCH.)

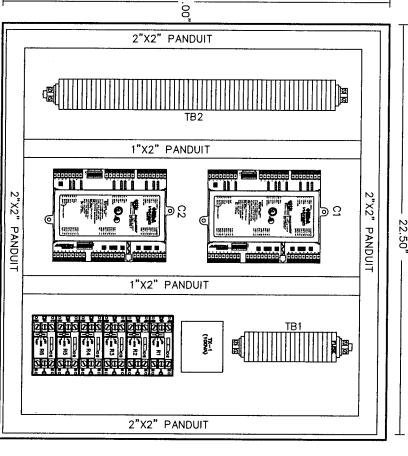

10 9 æ

VFD-2

FEEDBACK

A07 A06A05 404 403 402 6 Ġ

D.C

DP2 뭔

FINAL FILTER

≤

CHW VALVE POSITION

A01

B06 B05 B04 B03 B02 B01 B00 TUO

D.C

PRE FILTER

4 Ç ∾

> D.C D.C

VFD-2

ALARM

DP3

EF2-1 RUN STATUS

AHU-2 SUBPANEL LAYOUT

SEQUENCE OF OPERATIONS

maintain discharge air temperature sepoint of 11.47C (52.57F) and the min. outside airflow shall be maintained. When the outside air temperature drops below 11.47C (52.57F) the cooling coil control valve (V-1) shall be closed to the cooling coil and economizer, relief and return dampers (D-3, D-4, & D-5) shall modulate in sequence to maintain the discharge air temperature 11.47C (52.57F) two duct mounted static pressure sensors/controllers shall modulate the variable frequency drives mounted near the AHU, through a discriminator selector, to maintain a min.static pressure of 250Pa (1" wg) setpoint. The return air fan shall track the operation of supply air fan by maintaining a constant differential airflow equal to that of the min. outside air. Supply and return airflow-measuring stations mounted in the fan inlet's shall measure airflow's. A high static pressure sensor shall shut down both supply and return air fan other than the static pressure of 250Pa (5" wg). This controller shall be directly connected to the VFD drives and alarm the DDC system on the high static pressure shut down. AHU-1& 2
When the system is in operation as indicated the following sequence shall occur. The minimum out side airflow shall be measured through a duct-mounted airflow measuring station located in the outside air duct. When the outside air temperature is at or above 2.1°C (70°F) the minimum outside air damper (D-1) shall open, the return air and relief air dampers (D-2 & D-3) shall modulate to maintain the minimum outside airflow, the economizer and relief air dampers (D-4 & D-5) shall be closed and cooling coil control valve (V-1) shall modulate to maintain the discharge temperature at 11.4°C (52.5°F). When the outside air temperature is below relief air dampers (D to maintain the discharge temperature at 11.4°C (32.5°F). When the outside air 21°C (70°F), the min OA damper (D-1) shall be open, return air; economizer and -3, D-4 AND D-5) shall modulate in sequence with the cooling coil control (V-1) to

BUILDING COOL DOWN CYCLE (COOLING PERIOD ONLY)

Approximately 1- ½ hours before the normal time occupancy of the building occurs, the DDC system shall start, all start the HVAC system as follows: the return damper shall open, the AHU supply fans shall start, all interlocked exhaust fans shall remain off, CWP-1 and CWP-2 shall start and chiller WCl-1 shall operate when water flow is proven. All chilled water control valves for AHU cooling coil shall modulate to maintain their set point temperature. During this period of operation the outside damper shall remain closed. Approximately ½ hour before the normal occupancy period occurs the DDC system shall place the system in the normal occupied position, the outside damper shall open, interlocked exhaust fans shall start and the AHU system and cooling system shall continue to operate in their normal occupied sequence.

water flow is proven. All H.W. control valves for terminal unit coils shall modulate to maintain their occupied set point temperature. During this period of operation the outside air damper shall remain closed. Approximately ½ hour before the normal occupancy period occurs the DDC system shall place the system in the normal occupied position, the outside air damper shall open, interlocked exhaust fans shall start and the AHU systems and the heating systems shall continue to operate in their normal occupied sequence. BUILDING WARM-UP CYCLE (HEATING PERIOD ONLY)
Approximately 1- ½ hours before the normal time occupancy of the building occurs, the DDC system shall start the HVAC system as follows: the return damper shall open, the AHU supply fans shall start, all interlocked exhaust fans shall remain off, HWP-1 shall start, and the boiler B-1 shall be enabled when then water flow is proven. All H.W. control valves for terminal unit coils shall modulate to maintain their water flow is proven. All H.W. control valves for terminal unit coils shall modulate to maintain their


heating and /or cooling systems shall start and operate in its normal operating sequence. When the TU STAT has expired the AHU and heating and/or cooling systems shall stop and return to the normal unoccupied sequence. TIMED OVERRIDE CYCLE
Each terminal unit thermostat (TU T-STAT) shall be capable of overriding the system "OFF" cycle to provide periods of system override operation. The TU STAT shall override the operation of the DDC system "OFF" period, when the DDC system has the system off for unoccupied periods. The TU STAT shall have the capability to operate for a maximum period of 4 hours (adjustable from the central processor). When the TU a maximum perio normal unoccupied sequence. y set the associated AHU shall start in its normal sequence, and the


AS-BUILT 07/30/02

REV

DATE

ΒY

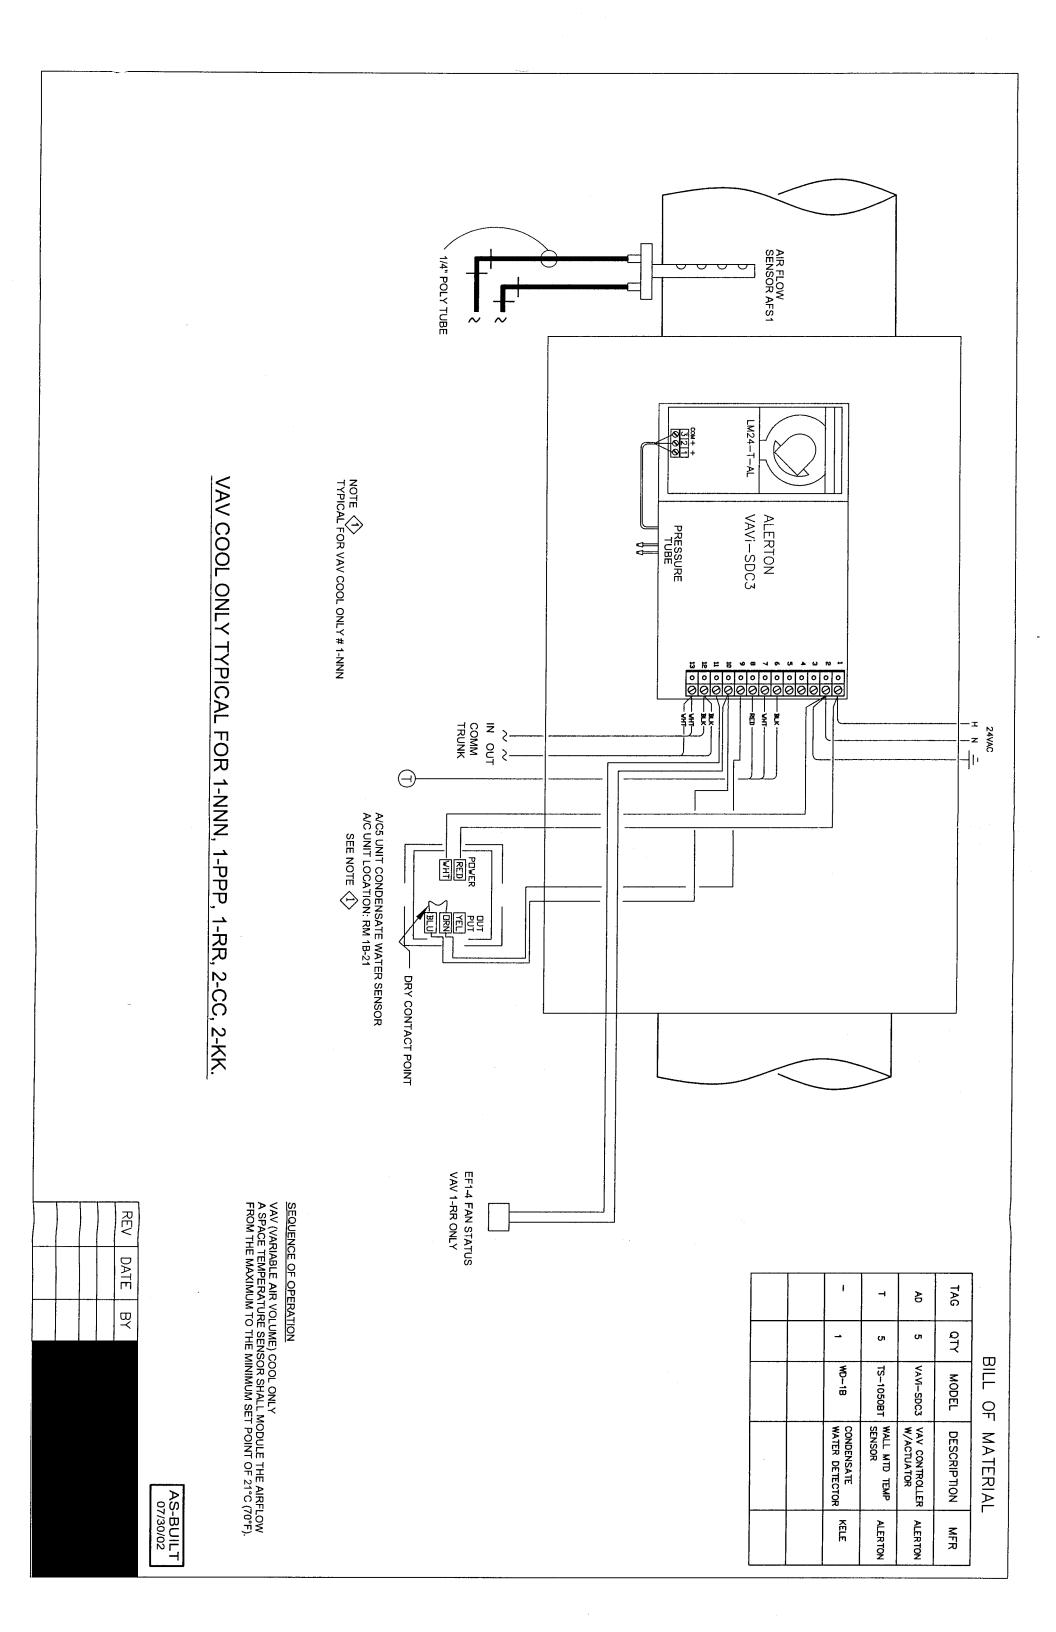

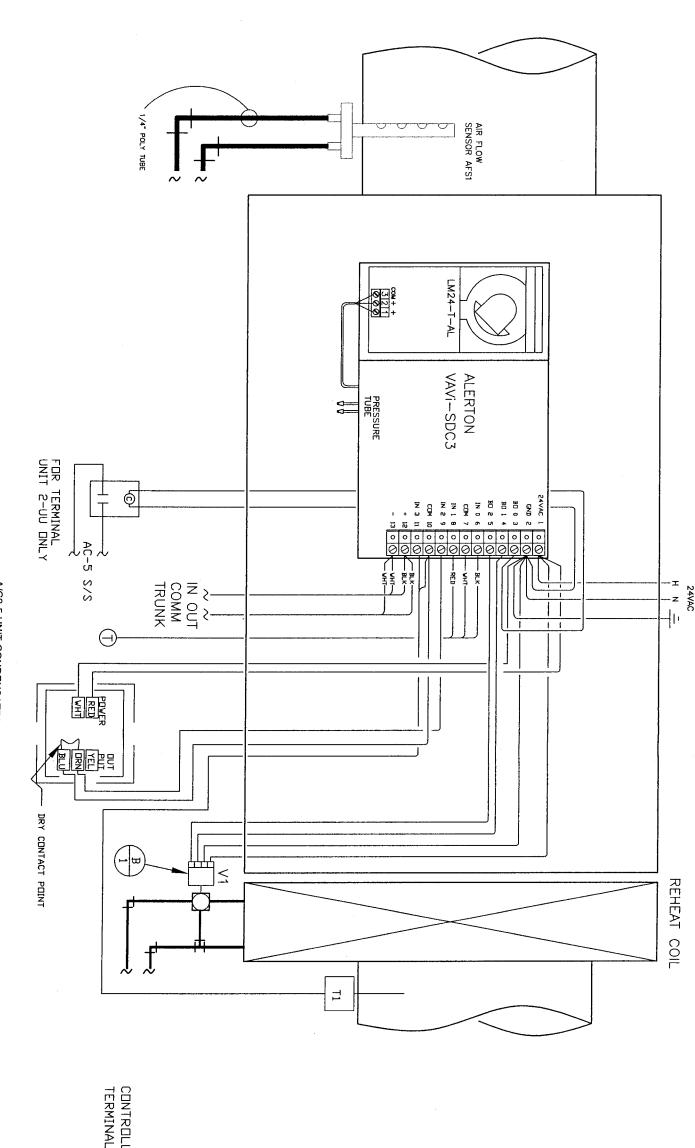

BILL OF MATERIAL

TAG ≤ ð ⇉ YTD SCHEDULE TS-2000BT DUCT TEMP. ALERTON TS-1050BT MODEL REHEAT VALVE WALL MTD TEMP SENSOR CONDENSATE WATER DETECTOR VAV CONTROLLER W/ACTUATOR DESCRIPTION BELIMO ALERTON **ALERTON** MFR

A/C2-5 UNIT CONDENSATE WATER SENSOR A/C UNITS LOCATION: A/C2 RM 1C-13, A/C3 RM 2B-12, A/C4 RM 2C-15, A/C5 RM 2D-4 SEE NOTE 〈1〉

NOTE (1)
TYPICAL FOR VAV W/REHEAT # 1-AA,
2-LLL, 2-AA & 2-UU.

CONTROLLER TERMINALS

CLOSE Y1 VALVE ACTUATOR M


V-1 DETAILS


07/30/02	AS-BUILT		
			REV
			DATE
			ВҮ

They shall be the same as VAV with relact above except controls shall be set for constant volume air low.

WAY CHARLAGE AIR NOLUTARY, WITH RIBLAT
A space temperature sensor thall modulate the airflow from the maximum to the
coincident airflow to maintain set point of 21°C (70°F). When the minimum airflow set
point is reached and on a further fall in space temperature the terminal unit hot water
control value shall modulate to maintain space temperature.

SEQUENCE OF OPERATION

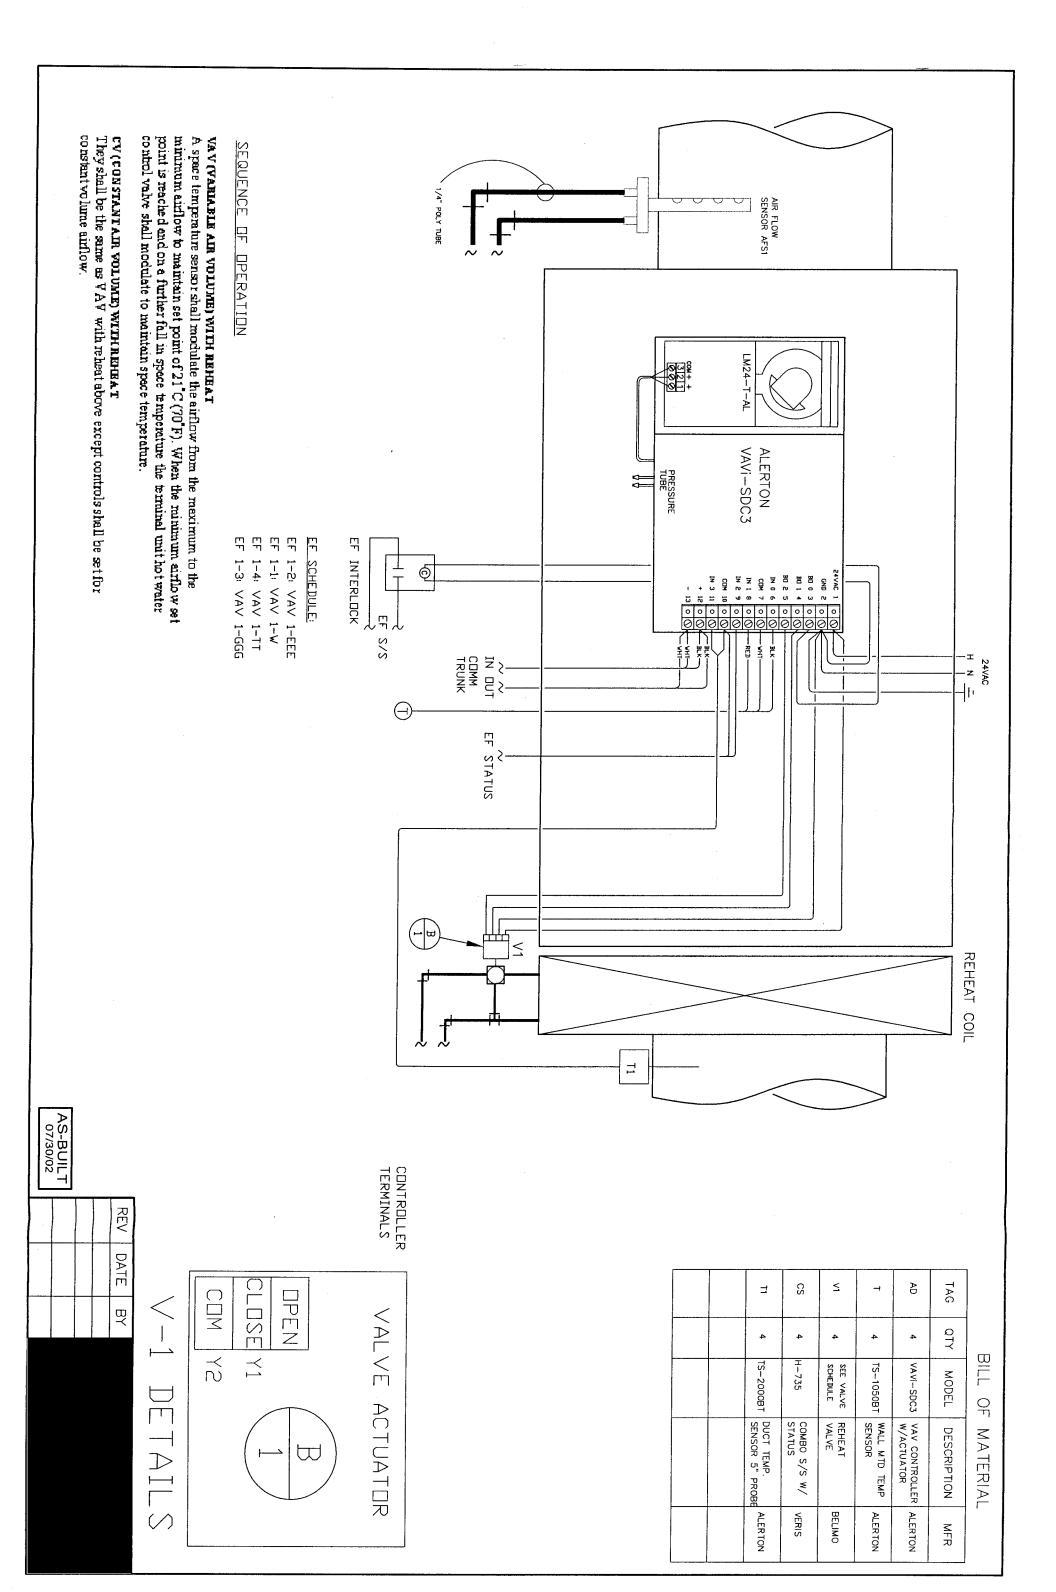

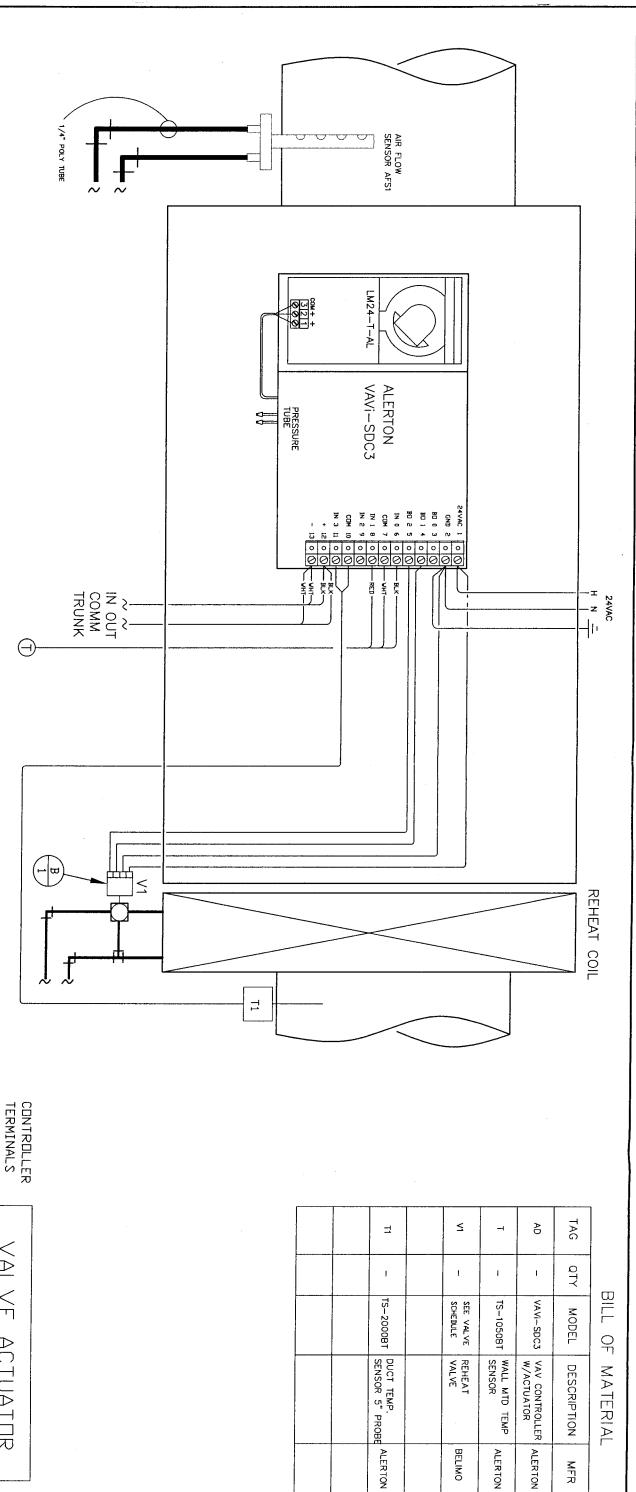

ALERTON

MFR

CLOSE Y1 PEN VALVE 2 ACTUATOR W

V-1 DETAILS

REV

DATE

В


AS-BUILT 07/30/02


SEQUENCE OF OPERATION

A space temperature sensor shall modulate the airflow from the maximum to the minimum airflow to maintain set point of 21°C (70°F). When the minimum airflow set point is reached and on a further fall in space temperature the terminal unit hot water control valve shall modulate to maintain space temperature.

constant volume airflow. CV (CONSTANT AIR VOLUME) WITH REHEAT


They shall be the same as VAV with reheat above except controls shall be set for

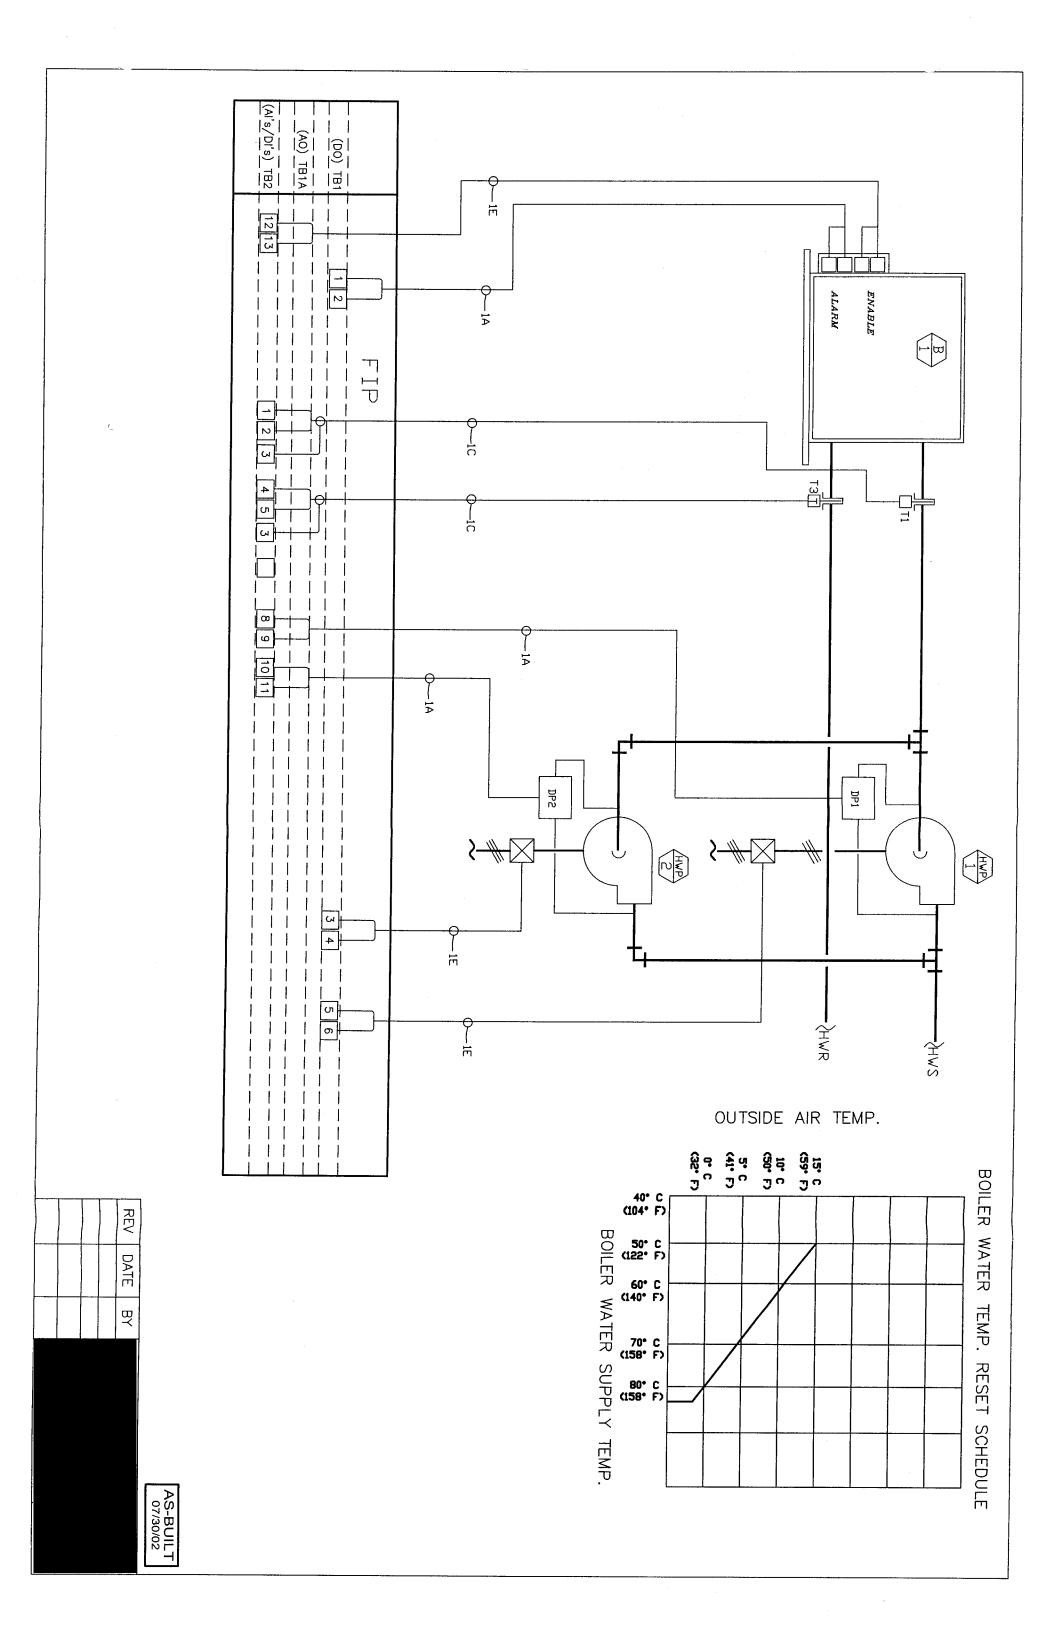

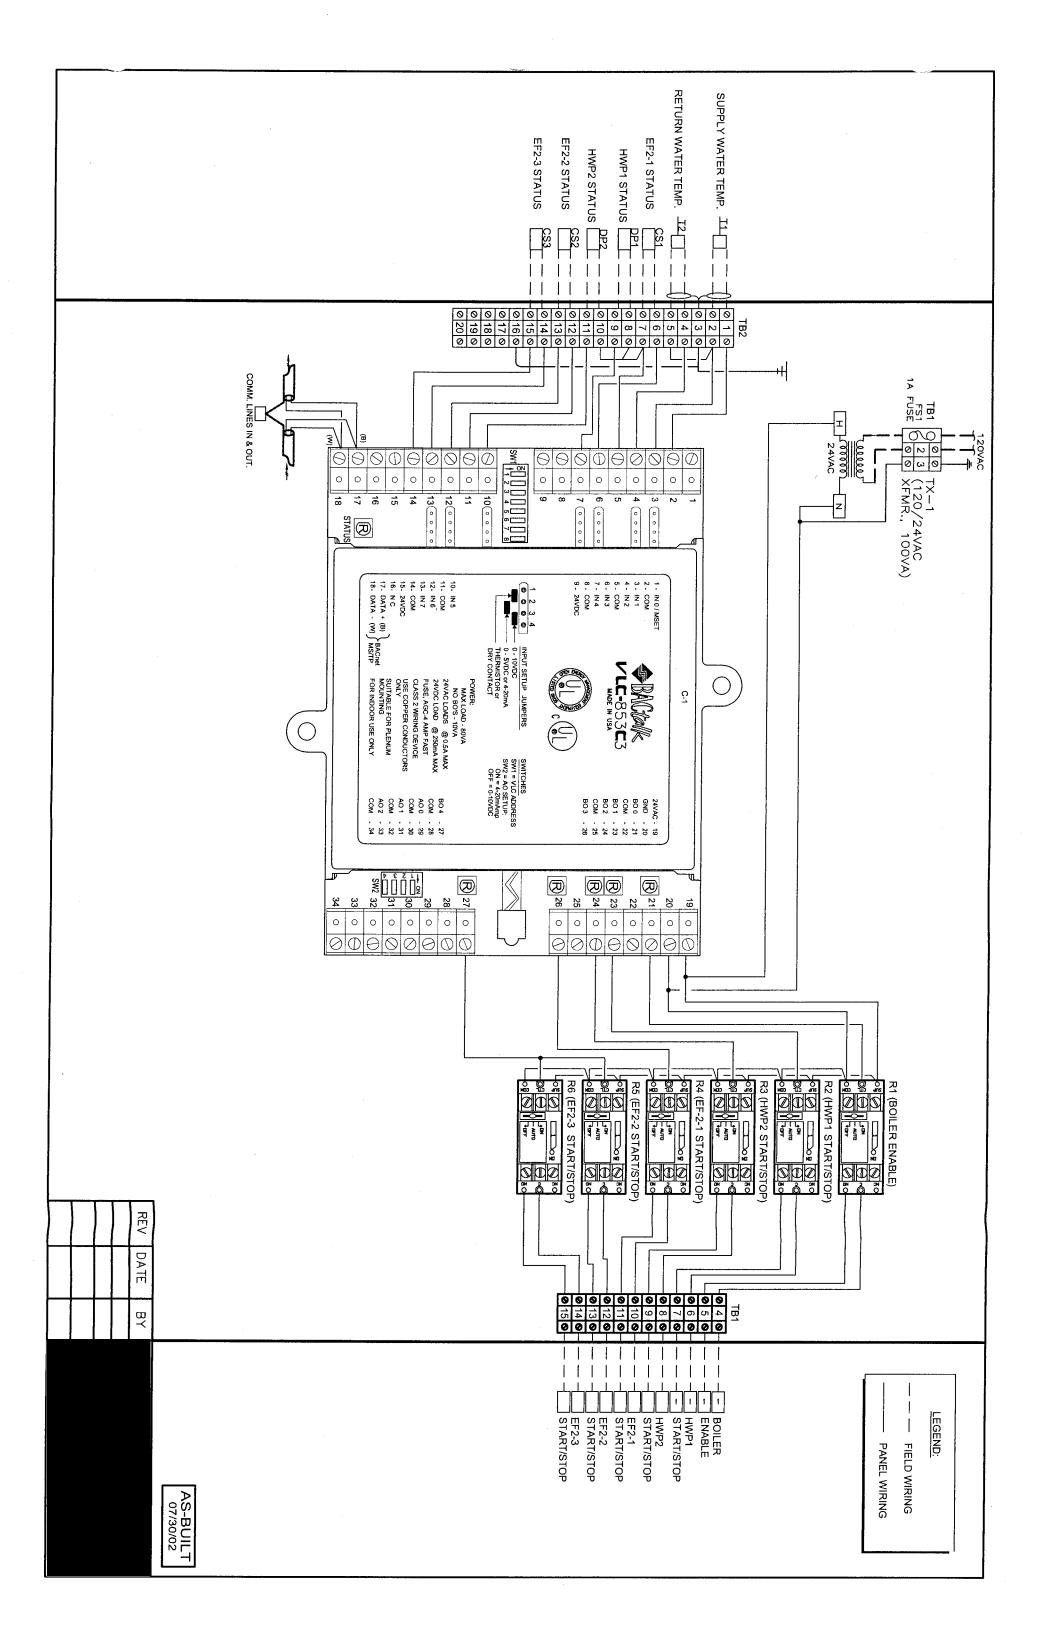

		FIEL	FIELD - BILL OF MATERIALS	
DEVICE	QUANTITY	PART#	DESCRIPTION	MANUFACTURER
11/12	2	TS-2100BT	2 1/2" IMMERSION TEMP SENSOR	ALERTON
DP1/DP2	2	24-013	DIFFERENTIAL SWITCH	XECE
끄	1	F61KB-11	FLOW SWITCH	KELE
•	2	TS-3100	2 1/2" PIPE WELL	ALERTON
CS1,2,3	3	H735	CURRENT SENSOR	VERIS
	,	•		•
,	•			•
,	•	•		,
'		•		-
'		•		

		SUBPA	SUBPANEL - BILL OF MATERIALS	
DEVICE	QUANTITY	PART#	DESCRIPTION	MANUFACTURER
				•
ន		VLC-853C3	CONTROLLER	ALERTON
7 <u>-</u> 1		691-K1	120/24VAC XFMR., 100VA	KELE
R1-R3	ω	MR-601T	RELAY WIHOA SWITCH	KELE
TB0-TB3	85	M4/6	TERMINAL BLOCK	KELE
****	8	FEM6	END SECTION	KELE
1	8	BAM	END STOPS	KELE
	2	M10/16SFL	FUSE W/HOLDER	KELE
FS1	1	AGC 1	1 AMP. GLASS FUSE	KELE
FS2	_	AGC 4	4 AMP. GLASS FUSE	KELE
F		A-24N24ALP	NEMA 1 ENCLOSURE, 24"WX24"Hx6"D	HOFFMAN
	_	A-24N24MP	SUBPANEL, 21.00"HX22.50"W	HOFFMAN

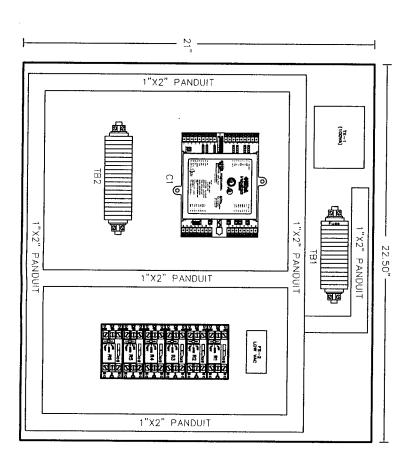

┙ **BOILER-1 SUBPANEL LAYOUT**

SEQUENCE OF OPERATIONS

indicate heating shall be reset as i #19). will operate through its own safety and operating controls to maintain 82°C (180°F). Boiler water temperature sensors located in the HWS and HWR at the boiler shall indicate heating water temperatures at the DDC system. The boiler water temperature HEATING SYSTEM

The heating control sequence shall be initiated as follows: when the control system is energized HWP-1 and HWP-2 shall start, through hand-off-auto switches (when in auto position), and shall provide flow to the system. When hot water flow is proven through the flow switches at the boiler then the boiler controls shall be energized and the boiler indicated on the boiler water reset schedule (see boiler control DWG.

Approximately 1 - ½ hours before the normal time occupancy of the building occurs, the DDC system shall start the HVAC system as follows: the return damper shall open, the AHU supply fans shall start, all interlocked exhaust fans shall remain off, HWP-1 shall start, and the boiler B-1 shall be enabled when then water flow is proven. All H.W. control valves for terminal unit coils shall modulate to maintain their occupied set point temperature. During this period of operation the outside air damper shall remain closed. Approximately ½ hour before the normal occupancy period occurs the DDC system shall place the system in the normal occupied position, the outside air damper shall open, interlocked exhaust fans shall start and the AHU systems and the heating systems shall continue to operate in their normal occupied sequence.


Each terminal unit thermostat (TU T-STAT) shall be capable of overriding the system "OFF" cycle to provide periods of system override operation. The TU STAT shall override the operation of the DDC system override the operation of the DDC system "OFF" period, when the DDC system has the system off for uno ccupied periods. The TU STAT shall have the capability to operate for a maximum period of 4 hours (adjustable from the central processor). When the TU STAT is manually set the associated AHU shall start in its normal sequence, and the heating and for cooling systems shall start and operate in its normal operating sequence. When the TU STAT has expired the AHU and heating and/or cooling systems shall stop and return to the normal unoccupied sequence.


AS-BUILT 07/30/02

REV

DATE

ВҮ

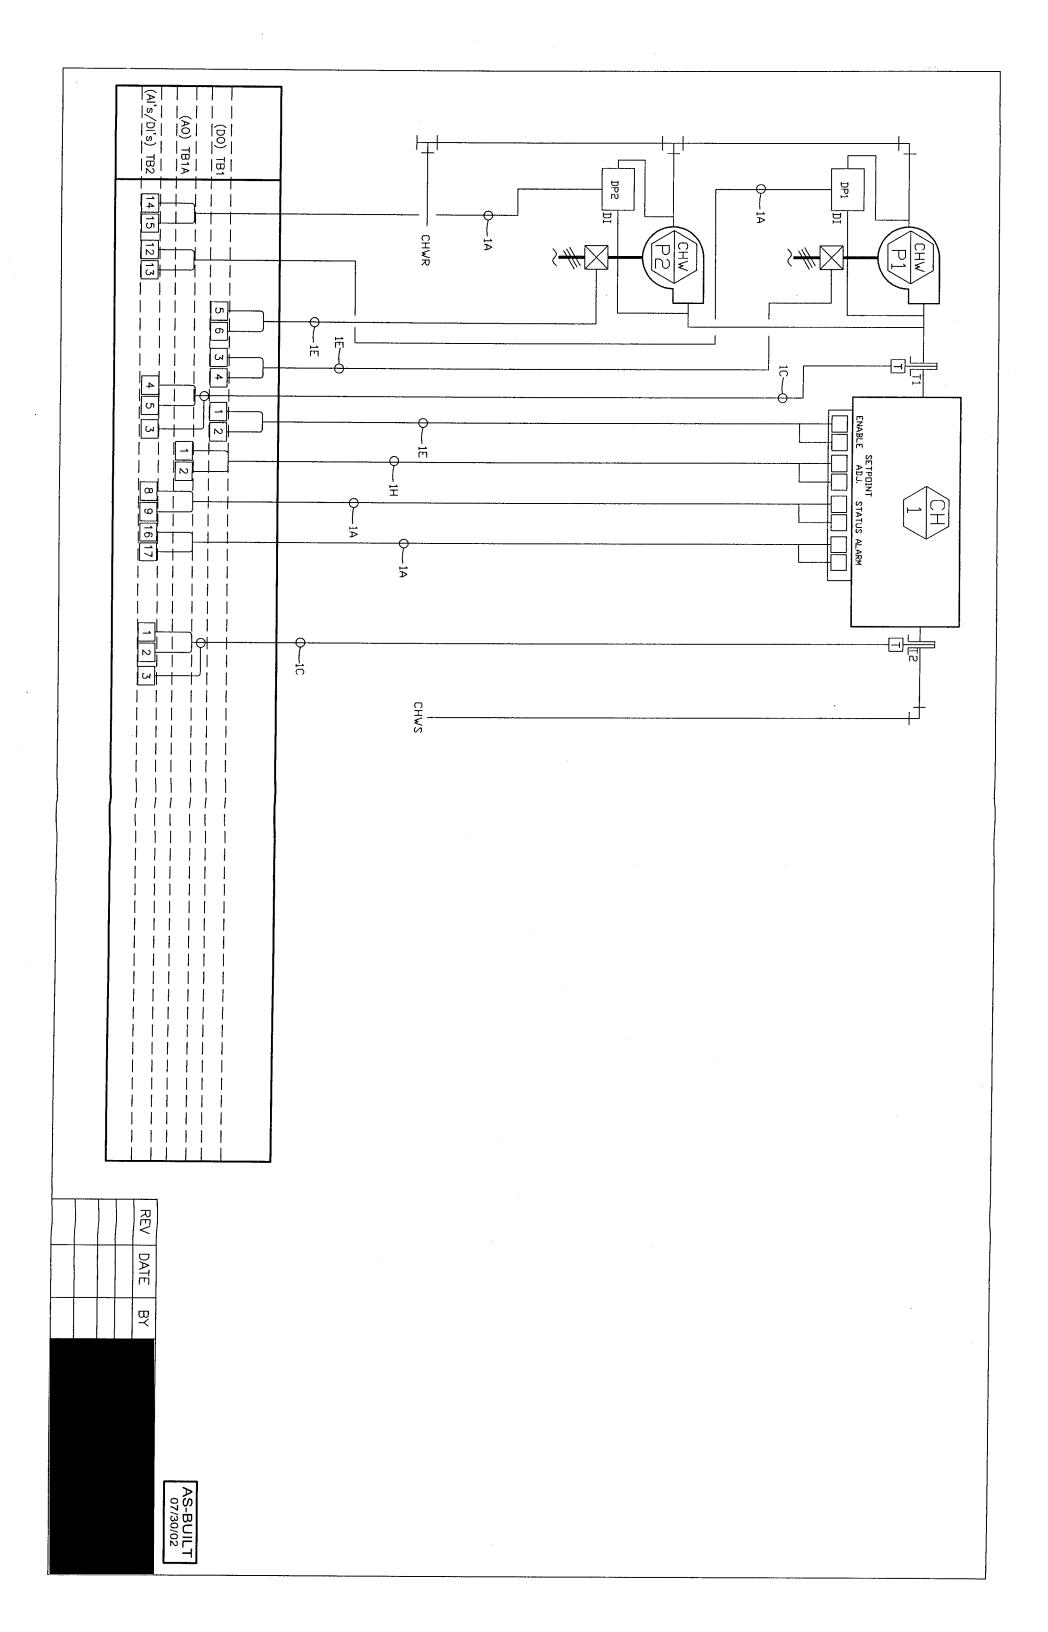


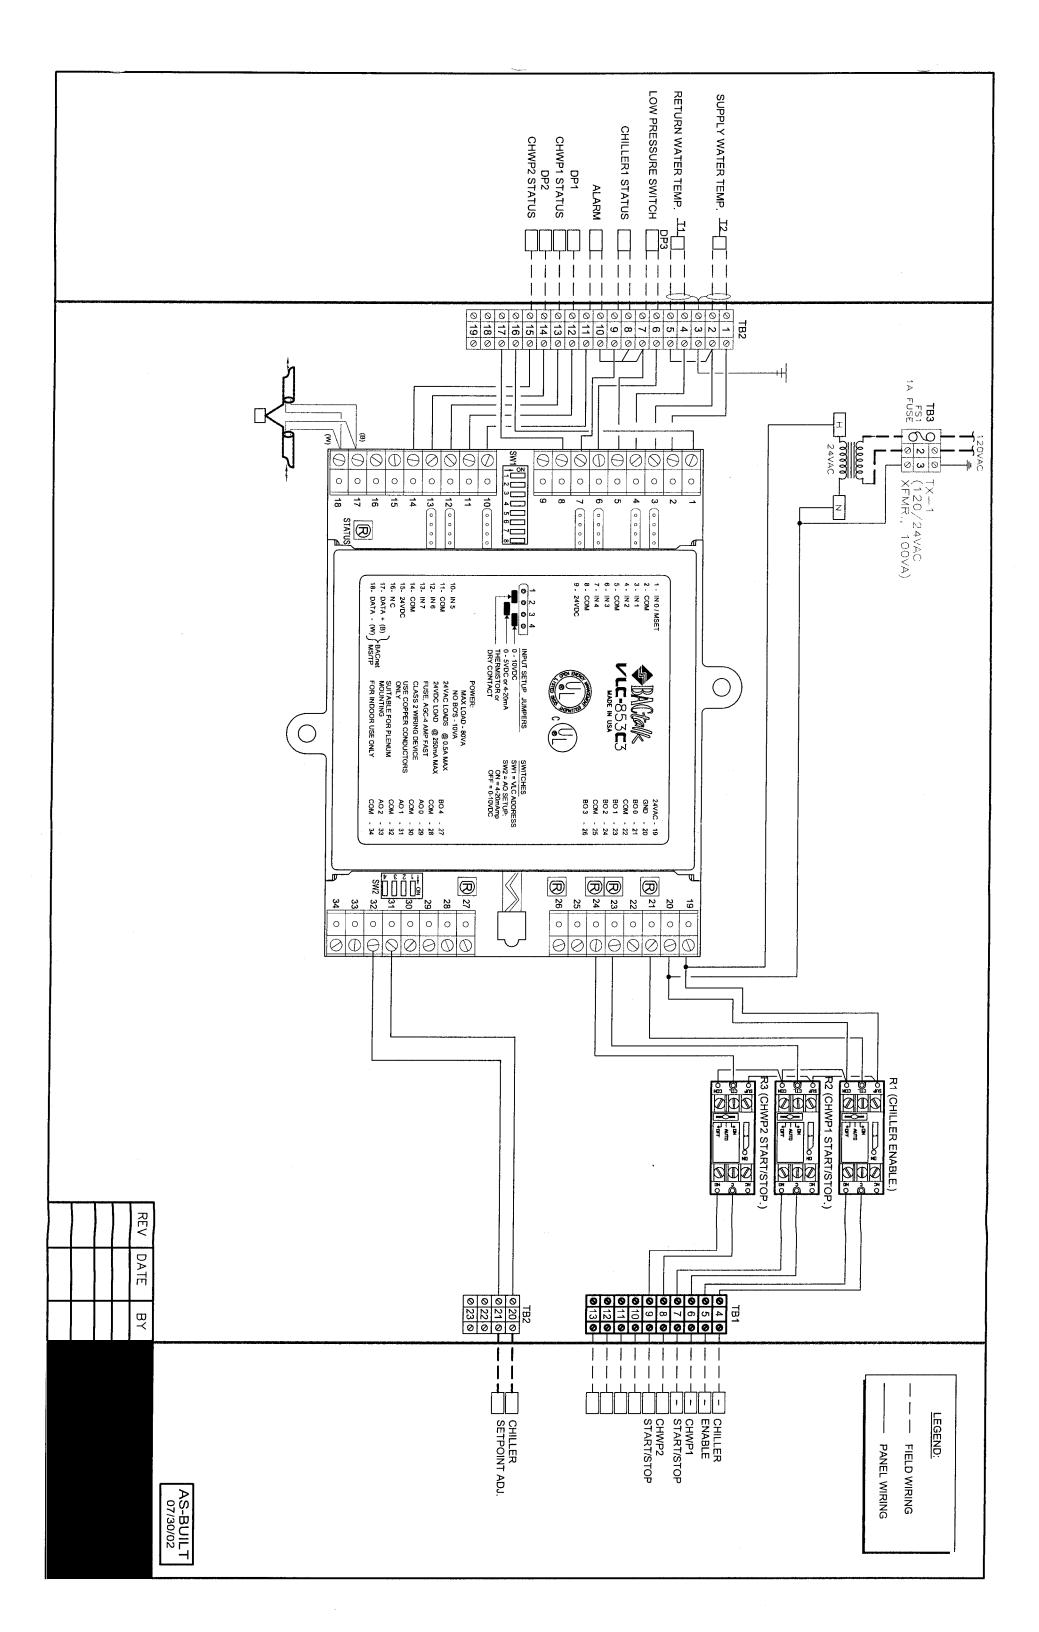

 1	,	A07					
-	,	A06					
1	-	A05					
P	•	A04		1		r	10
	-	A03		,	1	j	9
	•	A02					8
1	ı	A01	CHWP2 STATUS	CH	DP2	D.C	7
		B06	CHWP1 STATUS	오	DP1	D.C	9
		B05					5
		B04	CHILLER STATUS	오		D.C	4
1	-	B03	LOW PSI SW	ΓQV		1	3
CHWP2 START/STOP	R3	B02	RETURN WATER TEMP.	RE	Т1	THERM.	70
CHWP1 START/STOP	R2	B01	SUPPLY WATER TEMP.	SUF	Т2	THERM.	1
CHILLER1 ENABLE	R1	Воо	ALARM	ΑL	ı	D.C.	0
POINT	AUX	ОUТ	POINT		AUX	TYPE	Z
			7-1	LEF	CHILLER-1	SYSTEM:	SYS
		0-05	MAIN MECH. RM-2D-05	NI	MA	LOCATION:	LOC
ADDRESS: (SEE SCH.)	ADDI	3C3	TYPE:VLC-853C3	C1		CONTROLLER:	CO
	DULE	SCHE	CONTROLLER SCHEDULE				

	•				-	DP3		DP1/DP2	11/12	DEVICE	
		,			,	_	2	2	2	QUANTITY	
						AFS460	TS-3100	24-013	1	PART#	FIEL
	•					LOW PRESSURE SWITCH	2 1/2" PIPE WELL	DIFFERENTIAL PRESSURE SWITCH	6" IMMERSION SENSOR	DESCRIPTION	FIELD - BILL OF MATERIALS
,	-	•	•	•	•	KELE	ALERTON	KELE	ALERTON	MANUFACTURER	

		SUBPAI	SUBPANEL - BILL OF MATERIALS	
DEVICE	QUANTITY	PART#	DESCRIPTION	MANUFACTURER
-			1	•
22	1	VLC-853C3	CONTROLLER	ALERTON
TX.1	_	691-K1	120/24VAC XFMR., 100VA	KELE
R1-R3	ω	MR-601T	RELAY WIHOA SWITCH	KELE
ТВ0-ТВ3	85	M4/6	TERMINAL BLOCK	KELE
	8	FEM6	END SECTION	KELE
-	8	BAM	END STOPS	KELE
	2	M10/16SFL	FUSE W/HOLDER	KELE
FS1	_	AGC 1	1 AMP. GLASS FUSE	KELE
FS2		AGC 5	5 AMP. GLASS FUSE	KELE
ŧ	.	A-24N24ALP	NEMA 1 ENCLOSURE, 24"WX24"Hx6"D	HOFFMAN
		A-24N24MP	SUBPANEL, 21.00"HX22.50"W	HOFFMAN

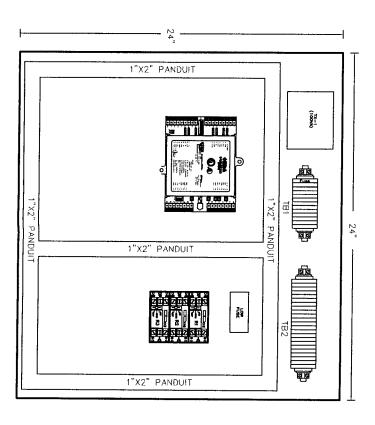

FIP CHILLER-1 SUBPANEL LAYOUT

SEQUENCE OF OPERATIONS

through the flow switch at the chiller then the chiller controls shall be energized and the chiller shall operate through its own safety and operating controls to maintain $\mathcal{T}C$ (44.6°F) discharge temperature. Temperature sensors located in the CWS and CWR at the chiller shall indicate the chiller water temperature at the DDC system. When the outside the outside air temperature is above 13°C (55.4°F) and when the control system is energized, CWP-1 and CWP-2 pumps shall start, through hand-off-auto switches (when in auto position), and shall provide flow to the system. When chilled water flow is proven temperature drops below 13° C (55.4 $^{\circ}$ F) the chiller system shall be deenergized. COOLING SYSTEM

The cooling control sequence shall be initiated from the DDC system as follows: when

BUILDING COOL DOWN CYCLE (COOLING PERIOD ONLY)

Approximately ½ how before the normal occupancy period occurs the DDC system shall place the system in the normal occupied position, the outside damper shall open interlocked exhaust fans shall start and the AHU system and cooling system shall Approximately 1-1/2 hours befare the normal time occupancy of the building occurs, the DDC system shall start the HVAC system as follows: the return damper shall open, the AHU supply fans shall start, all interlocked exhaust fans shall remain off, CWP-1 and CWP-2 shall start and chiller WCI-1 shall operate when water flow is proven. All chilled water control valves for AHU cooling coil shall modulate to maintain their set point continue to operate in their normal occupied sequence. temperature. During this penod of operation the outside damper shall remain closed

a maximum period of 4 hours (adjustable from the central processor). When the TU STAT is manually set the associated AHU shall start in its normal sequence, and the heating and for cooling systems shall start and operate in its normal operating sequence. When the TU STAT has expired the AHU and heating and/or cooling systems shall stop and return to the normal unoccupied sequence. TIMED OVERRIDE CYCLE
Each terminal unit thermostat (TU T-STAT) shall be capable of overriding the system
"OFF" cycle to provide periods of system override operation. The TU STAT shall
override the operation of the DDC system "OFF" period, when the DDC system has the
system off for unoccupied periods. The TU STAT shall have the capability to operate for e normal unoccupied sequence.

AS-BUILT 07/30/02

REV

DATE

Υ8

SEQUENCE OF OPERATIONS FOR ALL HVAC SYSTEMS AN D UNITS

SEQUENCE OF CONTROL

L GENERAL:

- (A)The DDC System shall place the systems in operation. When placed in operation the control system/s shall be energized thru hand—off auto switches (when in auto position), dampers shall open to their respective positions (See warm-up and cool down cycles indicated on M9-3) and after a variable time delay, Air Handling Unit Fan's and their interlock fans shall start.
- (B) Whenever the air handling unit/s are stopped, the control system shall be deenergized, ell dampers shall close, Air Handling Unit/s and interlocked fan/s shall
- (C) Any space/duct smoke detector sensing smoke shall signal the fire alarm control penel. The fire alarm control penel shall signal all air handling unit's with-in the shall open to their respective position. After a variable time delay, Air Handling Unit Fan's and interlocked fans shall restart. See (D) below for VFD Drive contactor for otherwise indicated, and all dampers shall close. The system may only be restarted air handling unit's with in the affected zone (smoke compartment) shall stop, unless bypass drive operation. clear signal is received, all smoke detectors, Etc. shall be automatically reset, dampers the fire department or other qualified personnel for the fire alarm panel. When an allfurnished and installed under the electrical section. When an alarm is received the affected zone (smoke compartment) that an alarm exists. The above control is
- (D) The Air Handling Unit Fan shall operate subject to the fire alarm system control. Any time the VFD Drive Supply or Return Air Fan is placed in the bypass position, all terminal units associated with that AHU Supply or Return Air Fan should open to 100% airflow.
- (E) Exhaust Fans EF1-1 through EF1-4 and EF2-1 through EF2-3 operation shall be monitored through the DDC system.

be open, return air, economizer and relief air dampers (D-3, D-4 AND D-5) shall modulate in sequence with the cooling coil control (V-1) to maintain discharge air temperature setpoint of 11.4°C (52.5°F) and the min. outside airflow shall be maintained. When the outside air temperature drops below 11.4°C (52.5°F) the cooling coil control valve (V-1) shall be closed to the cooling coil and economizer, relief and return dampers 11.4°C (52.5°F) two duct mounted static pressure sensors/controllers shall modulate the variable frequency drives mounted near the AHU, through a discriminator selector, to (D-3, D-4, & D-5) shall modulate in sequence to maintain the discharge air temperature valve (V-1) shall modulate to maintain the discharge temperature at 11. 4°C (52.5°F). When the outside air temperature is below 21°C (70°F), the min OA damper (D-1) shall dampers (D-2 & D-3) shall modulate to maintain the minimum outside airflow, the economizer and relief air dampers (D-4 & D-5) shall be closed and cooling coil control 21°C (70°F) the minimum outside air damper (D-1) shall open, the return air and relief air station located in the outside air duct. When the outside air temperature is at or above minimum out side airflow shall be measured through a duct-mounted airflow measuning When the system is in operation as indicated the following sequence shall occur. The

TERMINAL UNIT CONTROL:

control valve shall modulate to maintain space temperature. point is reached and on a further fall in space temperature the terminal unit hot water VAY (VARIABLEAIR VOLUME) WITH REHEAT
A space temperature sensor shall modulate the airflow from the maximum to the minimum a inflow to maintain set point of 21 °C (70 °F). When the minimum airflow set

CY (CONSTANT AIR VOLUME) WITH REHEAT

They shall be the same as VAV with re-heat above except controls shall be set for

VAV (VARIABLE AIR VOLUME) COOL ONLY

set point of 21°C A space temperature sensor shall module the airflow from the maximum to the minimum

COMPUTER ROOM (20-04) CONTROL TERMINAL UNIT 2010 & AC-5

2-UU airflow is at 100% of its maximum design airflow capacity and T.U 2-UU space AC-5 shall be provided with a microprocessor control system. In addition to controlling room temperature it shall also control room temperature it shall also control room temperature it shall also control room temperature. in the unit drain pan so that it will alarm the DDC system if condensate overslows and ACCU-5 shall cycle to maintain space temperature, when room temperature is temperature rises above the thermostatiset point temperature of 23°C. When the space temperature drops below the thermostatiset point AC-5 AND ACCU-5 shall be de-Terminal unit 2-UU shall be controlled same as VAV with reheat above except as herein modified. When AHU-2 is in operation, AC-5 and ACCU-5 shall cycle only when T.U. and ACC-5 system shall provide supplemental cooling when AHU-2 system is off: tred presp satisfied then AC-5 and ACC-5 shall stop. A condensate senset/switch shall be mounted thermostat control as follows : when space temperature rises above 23°C (73.4°F) AC-5 erergized. When AHU-2 is cdf AC-5 and ACCU-5 shall operate through T.U. 2-UU

OPTIMUM BUILDING START COOL DOWN CYCLE (COOLING PERIOD

interlocked exhaust fare shall start and the AHU system and cooling system shall AHU supply fars shall start, all interlocked exhaust fars shall remain off, CWP-1 and DDC system shall start the HVAC system as follows: the return damper shall open, the place the system in the normal occupied position, the outside damper shall open, A pproximately lpha hour before the normal occupancy period occurs the DDC system shall temperature. During this period of operation the cutside damper shall remain closed water control valves for AHU cooling coil shall modulate to maintain their set point ${
m CWP-}2$ shall start and chiller ${
m WCI-}1$ shall operate when water flow is proven. All chilled

COOLING SYSTEM The cooling control

(44.6°F) discharge temperature. Temperature sensors located in the CWS and CWR at the in auto position), and shall provide flow to the system. When chilled water flow is proven through the flow switch at the chiller then the chiller controls shall be energized and the the outside air temperature is above 13°C (55.4°F) and when the control system is temperature drops b chiller shall operate energized, CWP-1 and CWP-2 pumps shall start, through hand-off-auto switches (when chiller shall indicate elow 13°C (55.4°F) the chiller system shall be deenergized. sequence shall be initiated from the DDC system as follows: when through its own safety and operating controls to maintain $\mathcal{T} C$ the chiller water temperature at the DDC system. When the outside

HEATING SYSTEM

The heating control sequence shall be initiated as follows: when the control system is energized HWP-1 and HWP-2 shall start through hand-off-auto switches (when in auto position), and shall provide flow to the system. When hot water flow is proven through will operate through its own safety and operating controls to maintain 82° C (180° F). Builer water temperature sensors located in the HWS and HWR at the boiler shall shall be reset as indi indicate heating wat the flow switches at er temperatures at the DDC system. The boiler water temperature the boiler then the boiler controls shall be energized and the boiler cated on the boiler water reset schedule (see boiler control DWG

closed. Approximately ½ hour before the normal occupancy period occurs the DDC AHU supply fans sh HWP-2 shall start, a BUILDING WARM-UP CYCLE (HEATING PERIOD ONLY)

Approximately 1- 1/2 hours before the normal time occupancy of the building occurs, the DDC system shall start the HVAC system as follows: the return damper shall open, the systems shall continue to operate in their normal occupied sequence. shall open, interlocked exhaust fans shall start and the AHU systems and the heating H.W. control valve system shall place ti point temperature. and the boiler B-1 shall operate when then water flow is proven. All s for terminal unit coils shall modulate to maintain their occupied set ne system in the normal occupied position, the outside air damper nall start, all interlocked exhaust fans shall remain off, HWP-1 and)uring this period of operation the outside air damper shall remain tart the HVAC system as follows: the return damper shall open, the

overnide the operation of the DDC system "OFF" period, when the DDC system has the system off fir unoccupied periods. The TU STAT shall have the capability to operate fir "OFF" cycle to provide periods of system overnide operation. The TU STAT shall and return to the normal unoccupied sequence. When the TU STAT has expired the AHU and heating and/or cooling systems shall stop STAT is manually: TIMED OVERRIDE CYCLE

Each terminal unit thermostat (TU T-STAT) shall be capable of overnoting the system neating and for cooling systems shall start and operate in its normal operating sequence. a maximum period set the associated AHU shall start in its normal sequence, and the of 4 hours (adjustable from the central processor). When the

AS-BUILT 07/30/02

		REV
		DATE
		ВҮ

SECTION 3

Control Program Listings

Job Name:			Date:	10/10/2000					MS/TP Net	work # :	1001
Location:			Revision:	1/23/2002					MS/TP Bau	d Rate :	38400
								E.	thernet Net	vork#:	1
Job #:								L	Si Ethernet	MAC #:	
	Controller	MS/TP	Device	Unit						Box Size	Box Size
Area Served	Туре	MAC#	Instance	Controlled	Reheat	Max CFM	Min CFM	Max LPS	Min LPS	(in)	(mm)
LSI Router/Controller	LSI	000	100	N/A	N/A	N/A	N/A	N/A	N/A	N/A	N/A
Patient Admin/Reception	VAVSDC3	001	100101	VAV-1A	Hot Water	212	127	100	60	0	150
RMO Analysist	VAVSDC3	002	100102	VAV-1B	Hot Water	540	180	255	85	9	225
Tricare Office	VAVSDC3	003	100103	VAV-1C	Hot Water	191	85	90	40	6	150
Tricare Office	VAVSDC3	004	100104	VAV-1D	Hot Water	445	148	210	70	8	200
	VAVSDC3	005	100105		N/A	0	0			0	
Tricare Office	VAVSDC3	006	100106	VAV-1F	Hot Water	392	222	185	105	8	200
Central Waiting	VAVSDC3	007	100107	VAV-1G1	Hot Water	562	180	265	85	9	225
Central Waiting	VAVSDC3	800	100108	VAV-1G2	Hot Water	975	328	460	155	12	300
Pharmacy	VAVSDC3	009	100109	VAV-1H	Hot Water	498	191	235	90	9	225
Pharmacy	VAVSDC3	010	100110	VAV-1I	Hot Water	625	350	295	165	10	250
Lounge	VAVSDC3	011	100111	VAV-1J	Hot Water	138	74	65	35	5	125
Corridor	VAVSDC3	012	100112	VAV-1K	Hot Water	350	350	165	165	8	200
Corridor	VAVSDC3	013	100113	VAV-1L	Hot Water	805	763	380	360	12	300
Opt. Exam Office	VAVSDC3	014	100114	VAV-1M	Hot Water	265	180	125	85	7	175
TRMT Rm/Dirty Proc	VAVSDC3	015	100115	VAV-1N	Hot Water	445	445	210	210	8	200
Interaction Station	VAVSDC3	016	100116	VAV-10	Hot Water	477	434	225	205	9	225
Waiting/Activity Area	VAVSDC3	017	100117	VAV-1P	Hot Water	636	318	300	150	10	250
Interaction Station	VAVSDC3	018	100118	VAV-1Q	Hot Water	381	222	180	105	8	200
Interaction Station	VAVSDC3	019	100119	VAV-1R	Hot Water	275	275	130	130	7	175
Opt. Exam Office	VAVSDC3	020	100120	VAV-1S	Hot Water	159	106	75	50	5	125
Fundas Camera Rm	VAVSDC3	021	100121	VAV-1T	Hot Water	318	180	150	85	8	200
Visual Field	VAVSDC3	022	100122	VAV-1U	Hot Water	466	222	220	105	9	225
Screen Eye Test	VAVSDC3	023	100123	VAV-1V	Hot Water	212	117	100	55	6	150
Audio	VAVSDC3	024	100124	VAV-1W	Hot Water	180	85	85	40	6	150
Hist/INTV	VAVSDC3	025	100125	VAV-1X	Hot Water	498	233	235	110	9	225
Physical Exam	VAVSDC3	026	100126	VAV-1Y	Hot Water	360	159	170	7 5	8	200
Chief Areo Med	VAVSDC3	027	100127	VAV-1Z	Hot Water	170	85	80	40	5	125
PES Admin Office	VAVSDC3	028	100128	VAV-1AA	Hot Water	180	95	85	45	6	150
Physical Exam	VAVSDC3	029	100129	VAV-1BB	Hot Water	339	159	160	75	8	200
Waiting	VAVSDC3	030	100130	VAV-1CC	Hot Water	275	201	130	95	7	175
Provider Cubicles	VAVSDC3	031	100131	VAV-1DD	Hot Water	477	212	225	100	9	225
Interaction Station	VAVSDC3	032	100132	VAV-1EE	Hot Water	360	318	170	150	8	200
Waiting/Activity Area	VAVSDC3	033	100133	VAV-1FF	Hot Water	752	678	355	320	10	250
Team Interaction	VAVSDC3	034	100134	VAV-1GG	Hot Water	487	212	230	100	9	225
Group IS	VAVSDC3	035	100135	VAV-1HH	Hot Water	286	170	135	80	7	175
Provider Cubicles	VAVSDC3	036	100136	VAV-1II	Hot Water	392	222	185	105	8	200
Maiting (Anti-site Anti-	VAVSDC3	037	100137	1414		0	0			0	
Waiting/Activity Area	VAVSDC3	038	100138	VAV-1KK	Hot Water	593	593	280	280	9	225
Admin Wk Station	VAVSDC3	039	100139	VAV-1LL	Hot Water	265	138	125	65	7	175
Group IS	VAVSDC3	040	100140	VAV-1MM	Hot Water	286	170	135	80	7	175
Medical Rediness	VAVSDC3	041	100141	VAV-1NN	Hot Water	191	148	90	70	6	150
Provider Cubicles	VAVSDC3	042	100142	VAV-100	Hot Water	858	392	405	185	12	300
ISO Interaction Station	VAVSDC3	043	100143	VAV-1PP	Hot Water	275	275	130	130	7	175
BMET Wk Station	VAVSDC3	044	100144	VAV-1QQ	Hot Water	869	434	410	205	12	300
Electrical Room	VAVSDC3	045	100145	VAV-1RR	N/A	562	0	265	0	9	225
DEE Equipment Sterre	VAVSDC3	046	100146		N/A	0	0	<u> </u>		0	
BEE Equipment Storage	VAVSDC3	047	100147	VAV-1TT	Hot Water	360	297	170	140	8	200
Interaction Station	VAVSDC3	048	100148	VAV-100	Hot Water	434	286	205	135	8	200
Staff Lounge	VAVSDC3	049	100149	VAV-1VV	Hot Water	159	85	75	40	5	125
Pediatrics Waiting	VAVSDC3	050	100150	VAV-1WW	Hot Water	233	138	110	65	7	175
Pediatrics Waiting	VAVSDC3	051	100151	VAV-1XX	Hot Water	127	127	60	60	5	125

Job Name: Location:

Date: 10/10/2000 Revision: 1/23/2002

MS/TP Network #:

1001 38**4**00

MS/TP Baud Rate: 3
Ethernet Network #: 1

1-6-46									thernet Netv		1
Job #:		1						L	SI Ethernet		
	Controller	MS/TP	Device	Unit						Box Size	Box Size
Area Served	Туре	MAC#	Instance	Controlled	Reheat	Max CFM	Min CFM	Max LPS	Min LPS	(in)	(mm)
Interaction Station	VAVSDC3	052	100152	VAV-1YY	Hot Water	350	212	165	100	8	200
	VAVSDC3	053	100153			0	0			0	
Conference/Library	VAVSDC3	054	100154	VAV-1AAA	Hot Water	275	138	130	65	7	1 7 5
Receiving/Storage	VAVSDC3	055	100155	VAV-1BBB	Hot Water	1197	742	565	350	14	350
Tech Wk Station	VAVSDC3	056	100156	VAV-1CCC	Hot Water	381	275	180	130	8	200
ADP Equipment Space	VAVSDC3	057	100157	VAV-1DDD	Hot Water	201	85	95	40	6	150
Chief Log Office	VAVSDC3	058	100158	VAV-1EEE	Hot Water	339	212	160	100	8	200
HK Supervisor	VAVSDC3	059	100159	VAV-1FFF	Hot Water	699	286	330	135	10	250
Fac Mgr Office	VAVSDC3	060	100160	VAV-1GGG	Hot Water	328	148	155	70	8	200
Corridor	VAVSDC3	061	100161	VAV-1HHH	Hot Water	636	318	300	150	10	250
Corridor	VAVSDC3	062	100162	VAV-1III	Hot Water	117	117	55	55	4	100
Treatment Room	VAVSDC3	063	100163	VAV-1JJJ	Hot Water	222	222	105	105	6	150
Immuniztion Room	VAVSDC3	064	100164	VAV-1KKK	Hot Water	201	106	95	50	6	150
Interaction Station	VAVSDC3	065	100165	VAV-1LLL	Hot Water	127	74	60	35	5	125
Central Waiting	VAVSDC3	066	100166	VAV-1MMM	Hot Water	487	180	230	85	9	225
Elevator Equipment	VAVSDC3	067	100167	VAV-1NNN	N/A	1144	0	540	0	14	350
Corridor	VAVSDC3	068	100168	VAV-1000	Hot Water	286	244	135	115	7	175
Electrical Room	VAVSDC3	069	100169	VAV-1PPP	N/A	106	0	50	0	4	100
Radio Graphic Room	VAVSDC3	070	100170	VAV-1QQQ	Hot Water	826	328	390	155	12	300
Tech Wk Room	VAVSDC3	071	100171	VAV-1RRR	Hot Water	360	360	170	170	8	200
Reception	VAVSDC3	072	100172	VAV-1SSS	Hot Water	625	403	295	190	10	250
Central Waiting	VAVSDC3	073	100173	VAV-1TTT	Hot Water	975	328	460	155	12	300
Staff Lounge	VAVSDC3	074	100174	VAV-1UUU	Hot Water	583	583	275	275	9	225
LAB Office	VAVSDC3	075	100175	VAV-1VVV	Hot Water	233	106	110	50	7	175
Corridor	VAVSDC3	076	100176	VAV-1WWW	Hot Water	244	244	115	115	7	175
LAB	VAVSDC3	077	100177	VAV-1XXX	Hot Water	1547	1547	730	730	16	400
Reception	VAVSDC3	078	100178	VAV-1YYY	Hot Water	424	328	200	155	8	200
Specimen Toilet	VAVSDC3	079	100179	VAV-1ZZZ	Hot Water	551	180	260	85	9	225
Chiller	VLC-853C3	080	100180	CH-1	N/A	N/A	N/A	N/A	N/A	N/A	N/A
		081	100181		N/A	N/A	N/A	N/A	N/A	N/A	N/A
71		082	100182		N/A	N/A	N/A	N/A	N/A	N/A	N/A
		083	100183			·····					
<u> </u>		084	100184				<u> </u>				
		085	100185				· · · · · · · · · · · · · · · · · · ·		<u> </u>		
· · · · · · · · · · · · · · · · · · ·	1	086	100186	7-11-2-							
		087	100187							 	<u> </u>
**************************************		088	100188				<u> </u>	- -			
***************************************		089	100189								
		090	100190					·			
		091	100191			 					
		092	100192			 	<u> </u>		 	 	
		093	100193			 	 				
		094	100194			<u> </u>	 	 	 	 	
*	 	095	100195			 					
	 	096	100196				<u> </u>				
	 	097	100197			 		 	 		-
	 	098	100198			 	 	 	 	 	
	 	099	100190			 	 	 	 	 	
	 	100	100199					<u> </u>	 	 	
		101	100200			-	 			 	
	 	102	100201				 				
<u> </u>	+	102	100202		ļ	 	 		ļ	-	
L	l	103	100203	l	<u></u>	<u> </u>	L	<u> </u>	L	L	L

Job Name:

Date: 10/10/2000 MS/TP Network #: Location: Revision: 1/23/2002 MS/TP Baud Rate: Ethernet Network #: Job #: LSI Ethernet MAC #: Controller MS/TP Device Unit Box Size Box Size Area Served MAC# Type Instance Controlled Reheat Max CFM Min CFM Max LPS Min LPS (in) (mm) LSI Router/Controller LSI N/A N/A N/A N/A N/A N/A N/A N/A VAVSDC3 Library/Conf VAV-2A Hot Water Admin VAVSDC3 VAV-2B Hot Water Super Office VAVSDC3 VAV-2C Hot Water Sec Office VAVSDC3 VAV-2D Hot Water Dental Surgeon VAVSDC3 VAV-2E Hot Water OH Dir#1 VAVSDC3 VAV-2F Hot Water X-Ray VAVSDC3 VAV-2G Hot Water OH Dir # 2 VAVSDC3 VAV-2H Hot Water OH Dir # 3 VAVSDC3 VAV-2I Hot Water Dental Waiting Room VAVSDC3 VAV-2J Hot Water Gen. Dent. DTR #4 VAVSDC3 VAV-2K Hot Water Corridor VAVSDC3 VAV-2L Hot Water Gen. Dent. DTR #5 VAVSDC3 VAV-2M Hot Water DTR Support VAVSDC3 VAV-2N Hot Water Gen. Dent. DTR#6 VAVSDC3 VAV-2O Hot Water Consult VAVSDC3 VAV-2P Hot Water Gen. Dent. DTR#7 VAVSDC3 VAV-2Q Hot Water VAVSDC3 ounge VAV-2R Hot Water Gen. Dent. DTR VAVSDC3 VAV-2S Hot Water Staff Lockers/Toilet VAVSDC3 VAV-2T Hot Water Gen. Dent. DTR #9 VAVSDC3 VAV-2U Hot Water Central Issue VAVSDC3 VAV-2V Hot Water DIPC Decon VAVSDC3 VAV-2W Hot Water DIPC Clean VAVSDC3 VAV-2X Hot Water Corrido VAVSDC3 VAV-2Y Hot Water Ceramic Lab VAVSDC3 VAV-2Z Hot Water Prosth Lab VAVSDC3 VAV-2AA Hot Water Gen. Dent. DTR #10 VAVSDC3 VAV-2BB Hot Water Electrical VAVSDC3 VAV-2CC N/A PH Super VAVSDC3 VAV-2DD Hot Water BEE Tech VAVSDC3 VAV-2EE Hot Water Water Lab VAVSDC3 VAV-2FF Hot Water Trash VAVSDC3 VAV-2GG Hot Water PH Tech VAVSDC3 VAV-2II Hot Water Waiting VAVSDC3 VAV-2JJ Hot Water Electrical VAVSDC3 VAV-2KK N/A Office VAVSDC3 VAV-2LL Hot Water Conf/Group Tharapy VAVSDC3 VAV-2MM Hot Water n Tech Office VAVSDC3 VAV-200 Hot Water Office Exam Room VAVSDC3 VAV-2PP Hot Water Reception VAVSDC3 VAV-2QQ Hot Water Waiting VAVSDC3 VAV-2RR Hot Water Corridor VAVSDC3 VAV-2SS Hot Water Dir Info Mgr VAVSDC3 VAV-2TT Hot Water Computer Room VAVSDC3 VAV-2UU Hot Water Corridor VAVSDC3 VAV-2VV Hot Water Lib/Class Room VAVSDC3 VAV-2WW Hot Water Conf Room VAVSDC3 VAV-2XX Hot Water

Job Name: Location: Date: 10/10/2000 Revision: 1/23/2002

MS/TP Network #:

1002 38400

M

MS/TP Baud Rate :

Ethernet Network # :

								E	themet Netv	vork#:	1
Job #:		,						L	SI Ethernet	MAC #:	
	Controller	MS/TP	Device	Unit	ł					Box Size	Box Size
Area Served	Туре	MAC#	Instance	Controlled	Reheat	Max CFM	Min CFM	Max LPS	Min LPS	(in)	(mm)
Credentials Mgr	VAVSDC3	052	100252	VAV-2ZZ	Hot Water	699	297	330	140	10	250
RMO Director	VAVSDC3	053	100253	VAV-2AAA	Hot Water	222	85	105	40	6	150
OPS Squad Mgr	VAVSDC3	054	100254	VAV-2BBB	Hot Water	286	106	135	50	7	175
		055	100255			0	0			0	
Tech Office	VAVSDC3	056	100256	VAV-2DDD	Hot Water	392	222	185	105	8	200
CMDR Office	VAVSDC3	057	100257	VAV-2EEE	Hot Water	275	106	130	50	7	175
Sec/Waiting	VAVSDC3	058	100258	VAV-2FFF	Hot Water	265	117	125	55	7	175
Admin Office	VAVSDC3	059	100259	VAV-2GGG	Hot Water	191	85	90	40	6	150
QA/HRD Director	VAVSDC3	060	100260	VAV-2HHH	Hot Water	138	74	65	35	5	125
Super	VAVSDC3	061	100261	VAV-2III	Hot Water	350	159	165	75	8	200
Tech Office	VAVSDC3	062	100262	VAV-2JJJ	Hot Water	381	222	180	105	8	200
		063	100263			0	0			0	
Corridor	VAVSDC3	064	100264	VAV-2LLL	Hot Water	275	180	130	85	7	175
		065	100265			0	0			0	
AH-1	VLC-1188C3	066	100266	AH-1	N/A	N/A	N/A	N/A	N/A	N/A	N/A
AH-1 Misc Pts	VLC-1188C3	067	100267	AH-1	N/A	N/A	N/A	N/A	N/A	N/A	N/A
AH-2	VLC-1188C3	068	100268	AH-2	N/A	N/A	N/A	N/A	N/A	N/A	N/A
AH-2 Misc Pts	VLC-1188C3	069	100269	AH-2	N/A	N/A	N/A	N/A	N/A	N/A	N/A
Boiler	VLC-853C3	070	100270	B-1	N/A	N/A	N/A	N/A	N/A	N/A	N/A
		071	100271			0	0			0	
		072	100272			0	0			0	
		073	100273	"		0	0			0	
		074	100274			0	0			0	
		075	100275			0	0			0	
		076	100276			0	0			0	
		077	100277			0	0			0	
		078	100278			0	0			0	
		079	100279			0	0			0	
		080	100280								
		081	100281			_					
		082	100282								
		083	100283								
		084	100284								
		085	100285								
		086	100286								
		087	100287								
		088	100288			1		ļ			
		089	100289								
		090	100290							-	

SECTION 4

Current Operating Parameters

		C together	briting	Current Oversting Baramatore			
AHII-1:		IAHII-2	el atili ig	Reheat VAV Roy:		Cooling Only VAV Boy	
Point	Value	Value Point	Value Point	Point	Value Point	Point	Value
Temperature (°F)		Temperature (°F)	222	Temperature (°F)	200	Temperature (*E)	
Man. Supply Air Temp StPt	55.0		55.0	55.0 Occupied Setpoint	72.0	72.0 Occupied Setpoint	72.0
Auto-Reset SA StPt Hi Limit	65.0	Auto-Reset SA StPt Hi Limit	65.0	Occ StPt Hi Limit	74.0	Occ StPt Hi Limit	74.0
Auto-Reset SA StPt Low Limit	50.0	50.0 Auto-Reset SA StPt Low Limit	50.0	Occ StPt Low Limit	70.0	Occ StPt Low Limit	70.0
Warmup Supply Temp StPt	80.0	80.0 Warmup Supply Temp StPt	80.0	Microtouch Bias	2.0	Microtouch Bias	2.0
Supply Temp Low Limit	35.0	35.0 Supply Temp Low Limit	35.0	Heating offset	2.0	Heating offset	2.0
Pressure (in w.c.)		Pressure (in w.c.)		Cooling Offset	0.0	Cooling Offset	0.0
Manual Supply Pressure StPt	1.0	Manual Supply Pressure StPt	1.0	Unoccupied Htg StPt	55.0	Unoccupied Htg StPt	55.0
Auto-Reset Supply Pressure Hi Limit	2.0	Auto-Reset Supply Pressure Hi Limit	2.0	Unoccupied Clg StPt	85.0	Unoccupied Clg StPt	85.0
Auto-Reset Supply Pressure Low Limit	0.5	Auto-Reset Supply Pressure Low Limit	0.5	Zone Mode Control		Zone Mode Control	
Supply Pressure Warmup Setpoint	1.0	Supply Pressure Warmup Setpoint	1.0	Afterhours Limit	2.0	Afterhours Limit	2.0
Max Supply Return Fan Differential	10%	Max Supply Return Fan Differential	10%	DamperiControl		Damper Control	
				int	Note 1	Note 1 Max CFM Setpoint	Note 1
Economizer		Economizer		Min CFM Setpoint	Note 1	Min CFM Setpoint	Note 1
OSA Economizer Lockout Setpoint	75.0	OSA Economizer Lockout Setpoint	75.0	Reheat CFM Setpoint	Note 1		
Economizer Minimum Position	10%	Economizer Minimum Position	10%	Box Size	Note 1	Box Size	Note 1
				Damper Motor Speed (sec.)	100.0	100.0 Damper Motor Speed (sec.)	100.0
Filter Runtime Hours Alarm Setpoint	3000	Filter Runtime Hours Alarm Setpoint	3000	Reheat Valve			
				Reheat Valve Motor Speed (sec.)	100.0		
Boiler Control:		Chiller Control:		NOTES:			
Plant Minimum On Time (min)	30.0	30.0 Plant Minimum On Time (min)	30.0	1. See Controller Matrix in Section 3 for Min/Max Flows and Box size information.	for Min	Max Flows and Box size informatio	
Plant Minimum Off Time (min)	10.0	Plant Minimum Off Time (min)	10.0				
Outside Air Lockout Setpoint (°F)	80.0	80.0 Outside Air Lockout Setpoint (°F)	50.0				

SECTION 5

Design Information

This section intentionally left blank

SECTION 6

Control Equipment Cut Sheets


Contents:


6A Alerton Products

6B Outside Purchases

SECTION 7


Backup of Control Program

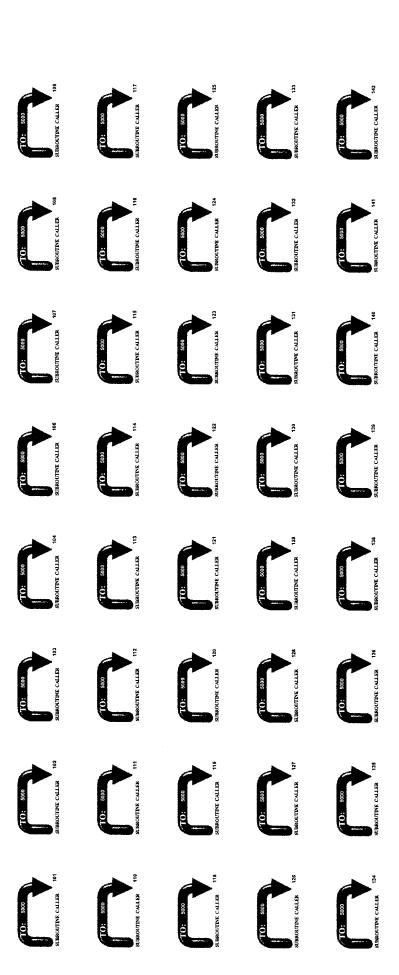

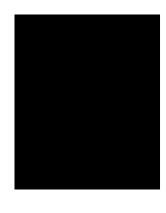





Device Settings

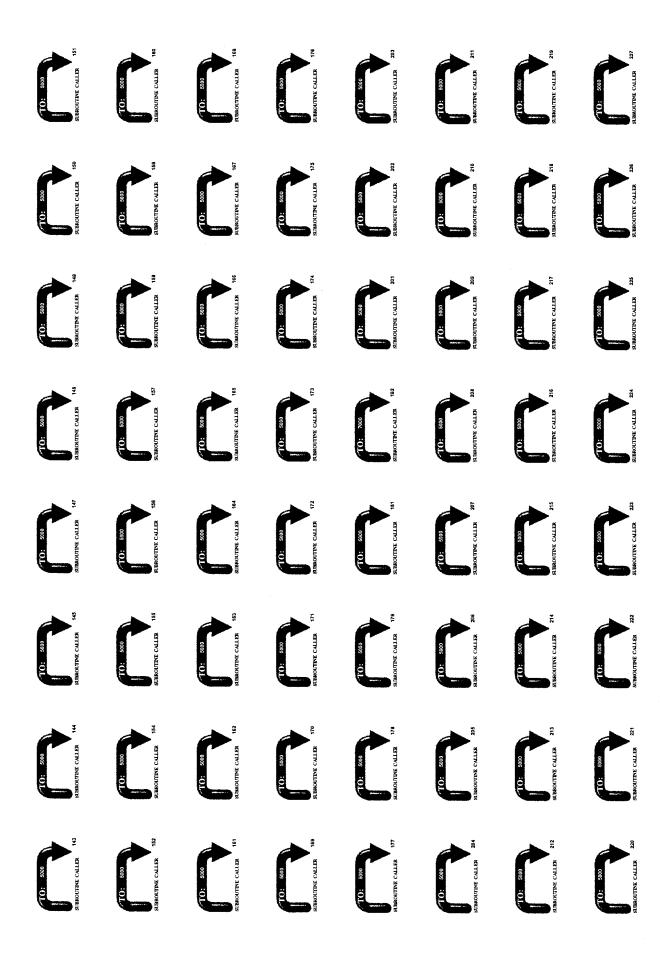





"TO: 5000	SUBSOUTHE CALER 236	TO: 5000	SUBROUTINE CALLER 245	TO: 5000	SURGUTIVE CALLER 284	TO: 5000	SUBROUTIVE CALLER 284		
TO: 5000	SURGUTINE CALLER 225	TO: 5000	STAROUTOFF CALLER 244	TO: 5600	STROUTHE CALLER 223	TO: 5000	SUBROUTIVE CALLER 282		
.TO: 5000	SURKOUTH'E CALLER 233	TO: 5000	STROUTIVE CALLER 243	TO: 8000	SIRBOUTIVE CALLER 252	10: 2000	SUBROUTIVE CALLER 261		
TO: 5000	SURROUTHE CALLER 222	TO: 5000	STROUTHE CALLER 242	TO: 5000	STROUTHE CALLER 250	1.03 5000	STEROUTIVE CALLER 260		
-TO: 5000	SURROUTRE CALLER 231	TO: 5000	SUBSOUTIVE CALLER 241	TO: 5000	STROUTIVE CALLER 248	10: 5000	SURROUTIVE CALLER 239		
TO: 5000	STREOUTINE CALLER 230	TO: sono	SURROUTIVE CALER 229	TO: 5000	SURROTTIVE CALLER 244	TO: 5000	STAROUTIVE CALLER 729		
TO: 5000	SIMBOUTINE CALLER 228	TO: 5000	SUBROUTIVE CALLER 228	TO: Sono	SUBSOUTINE CALLER 247	TO: soon	SUBROUTINE CALLER 257	TO: 7000	SUBROUTINE CALLER 267
TO: 5000	SUBROUTIVE CALER 228	10: 5000	STIRROUTIVE CALLER 237	TO: 5000	STIMOUTINE CALLER 246	TO; 5000	SUBROUTINE CALLER 256	TO: 6000	SUBROUTINE CALLER 266

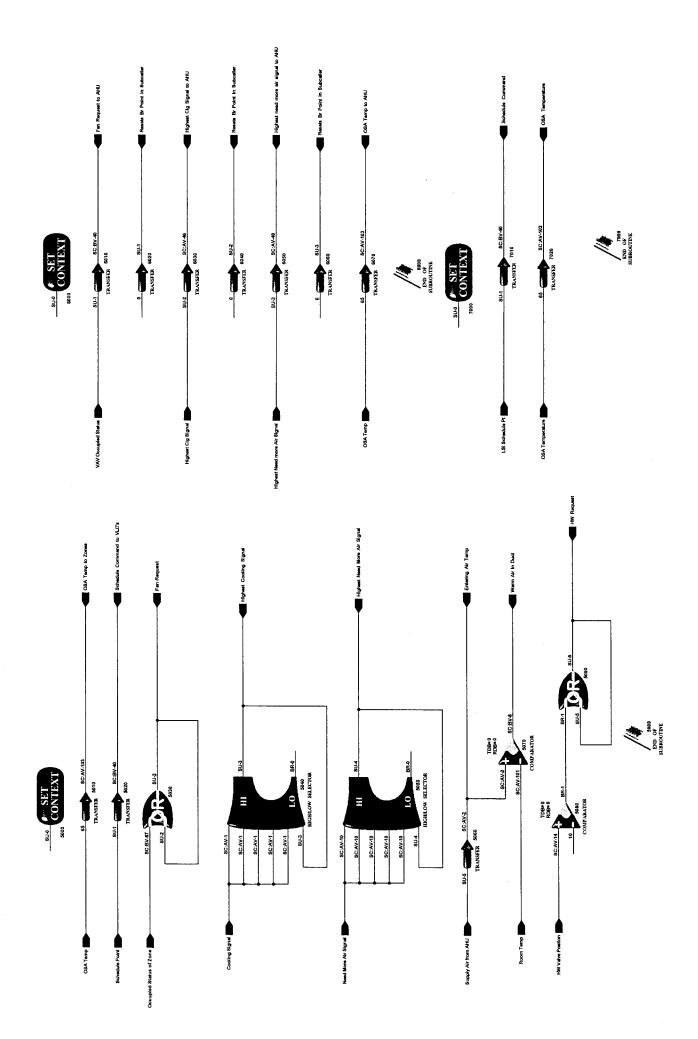


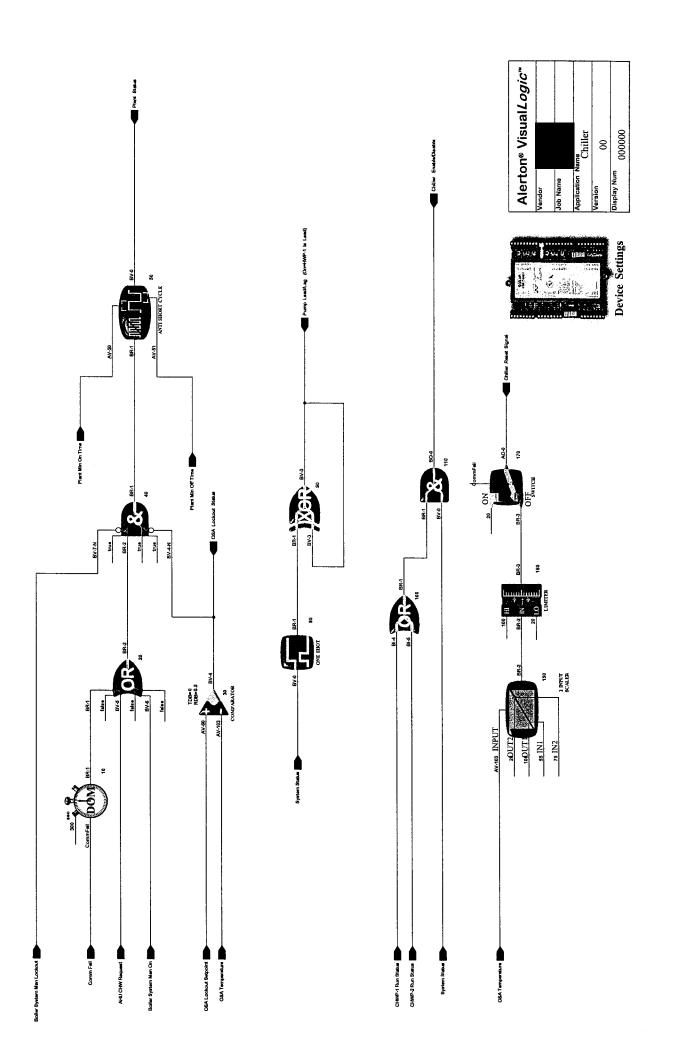


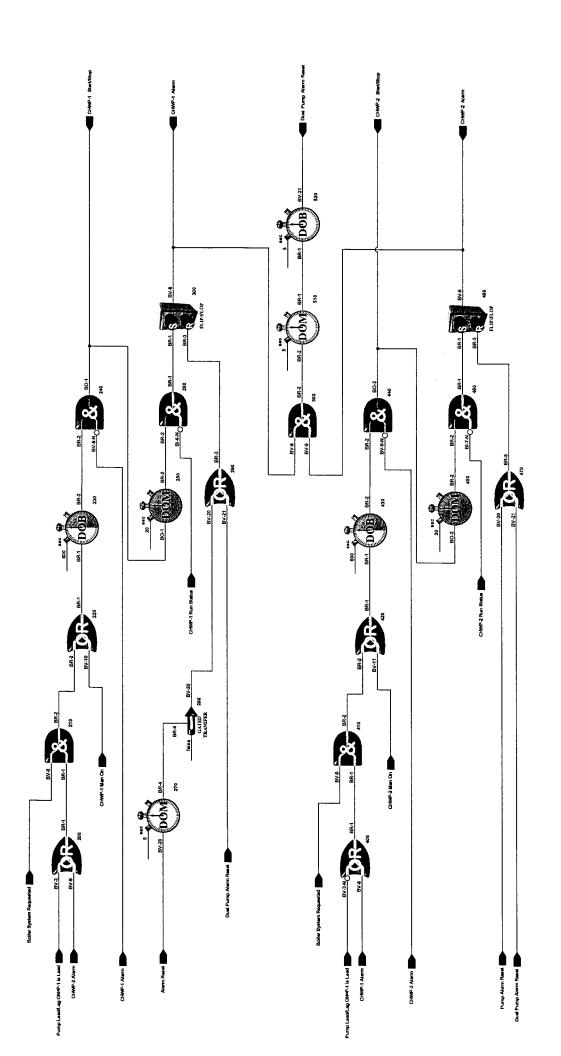




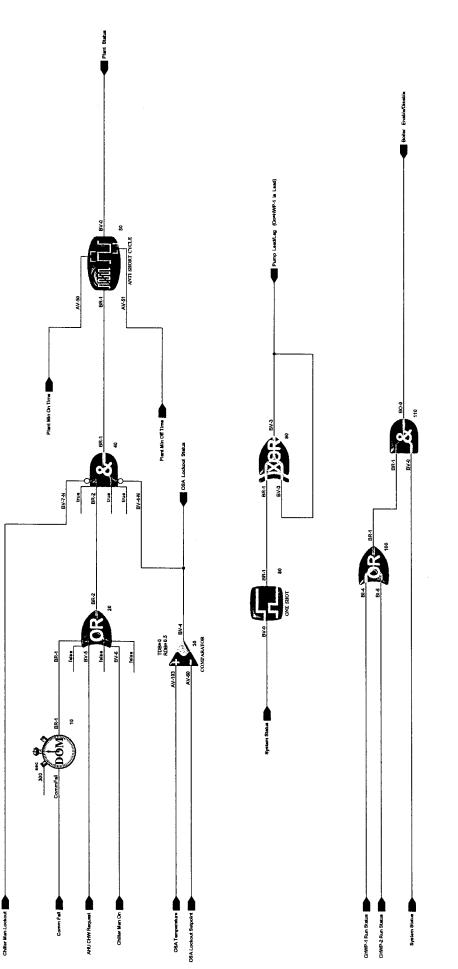


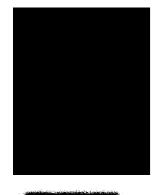

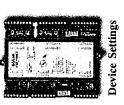

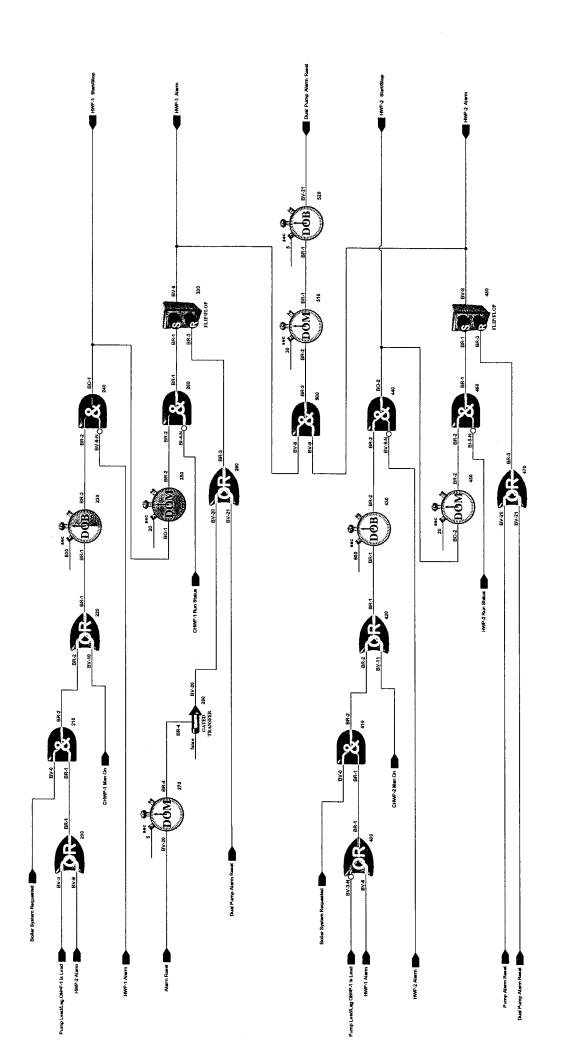





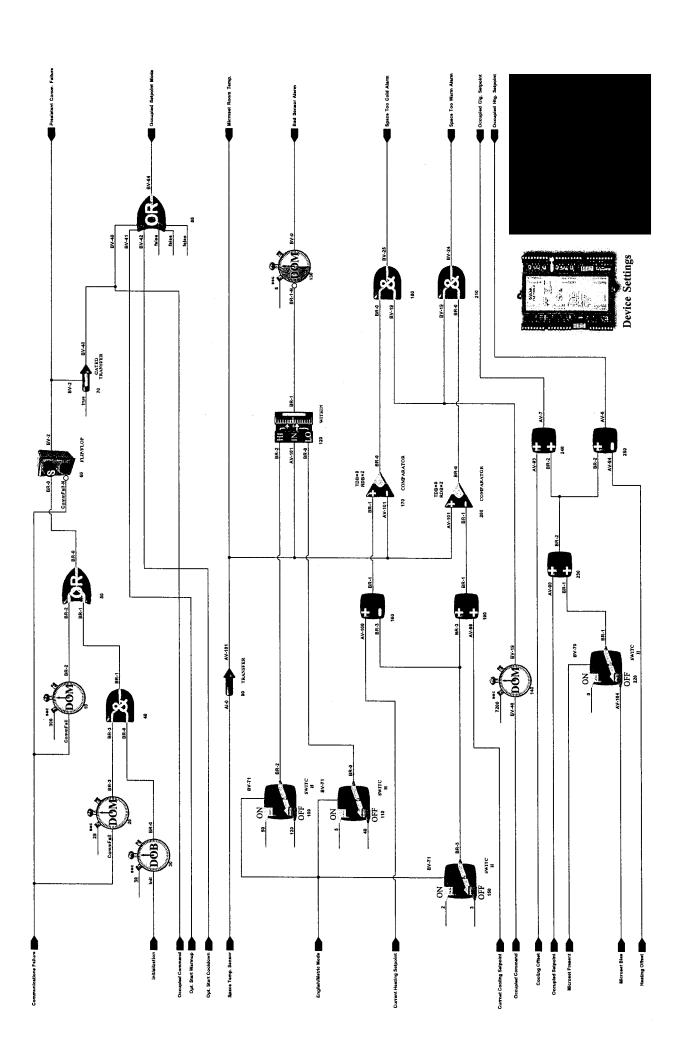


VIONOG Dana 1

'n

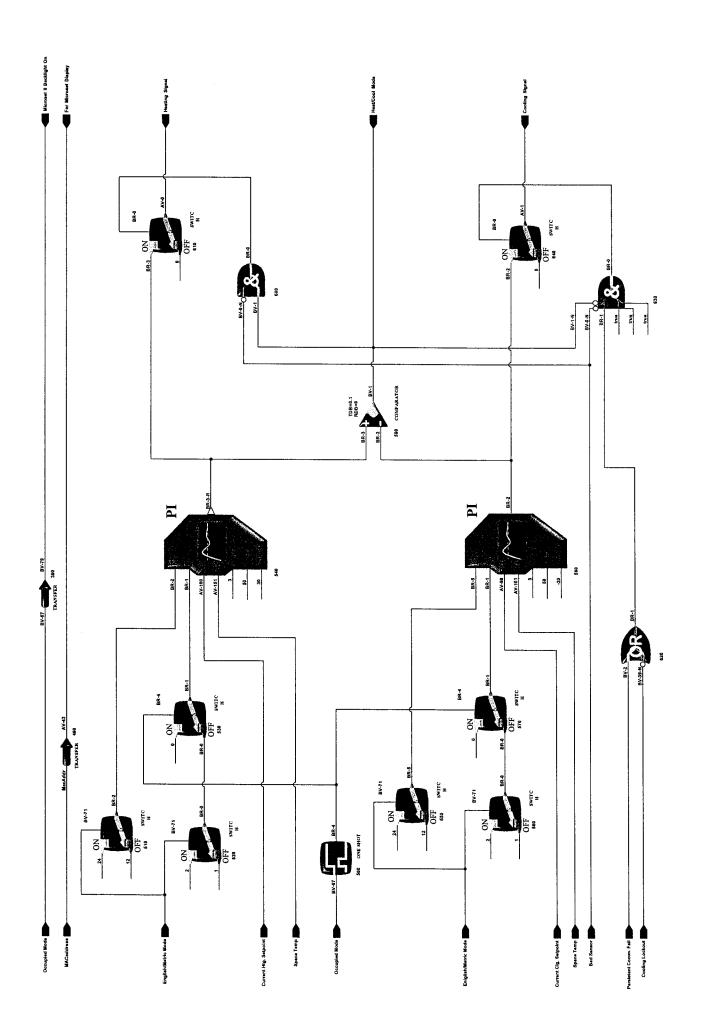


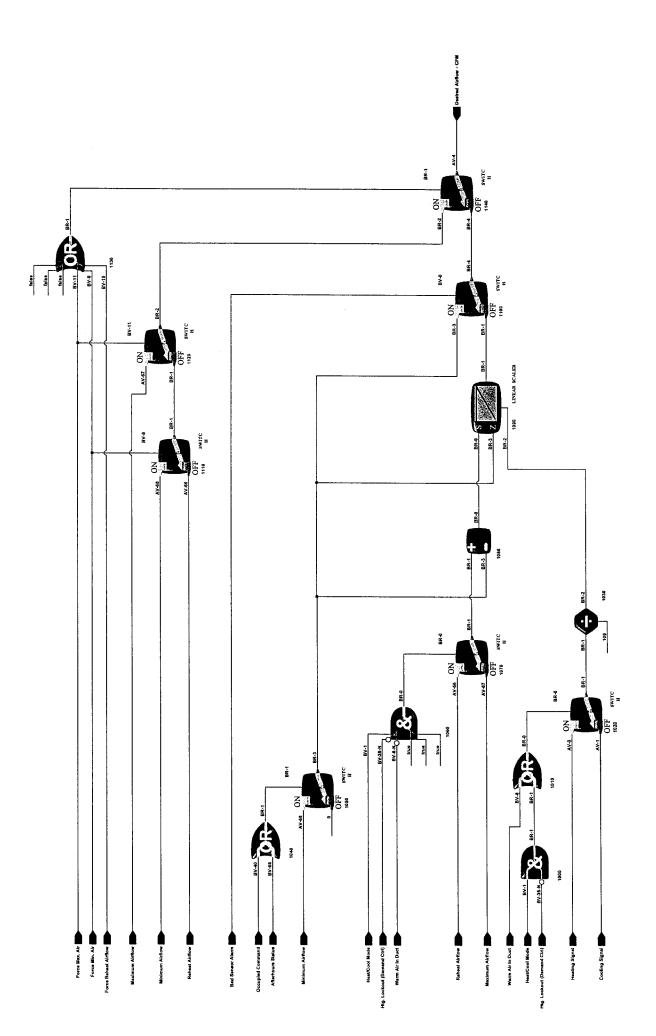


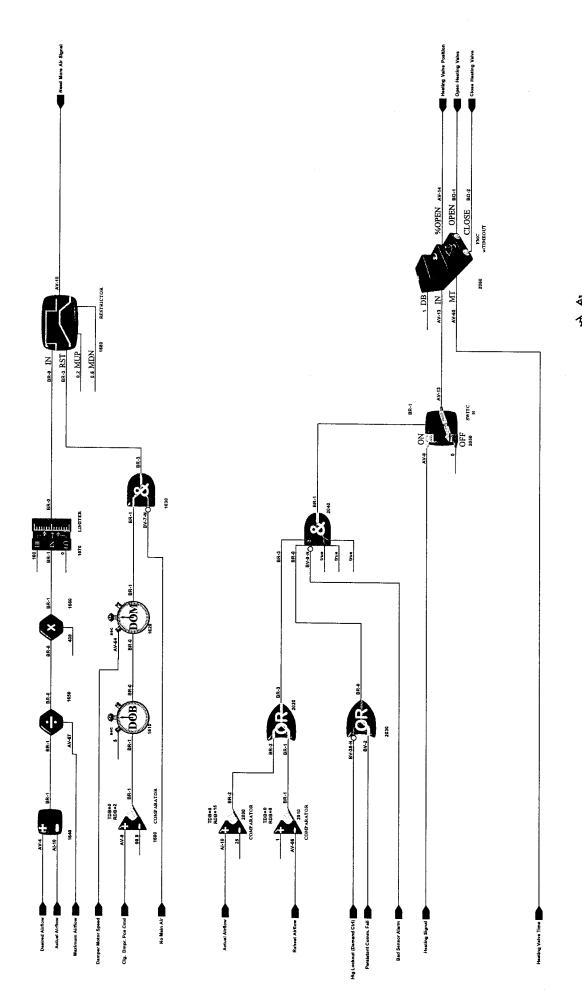





1 (((()

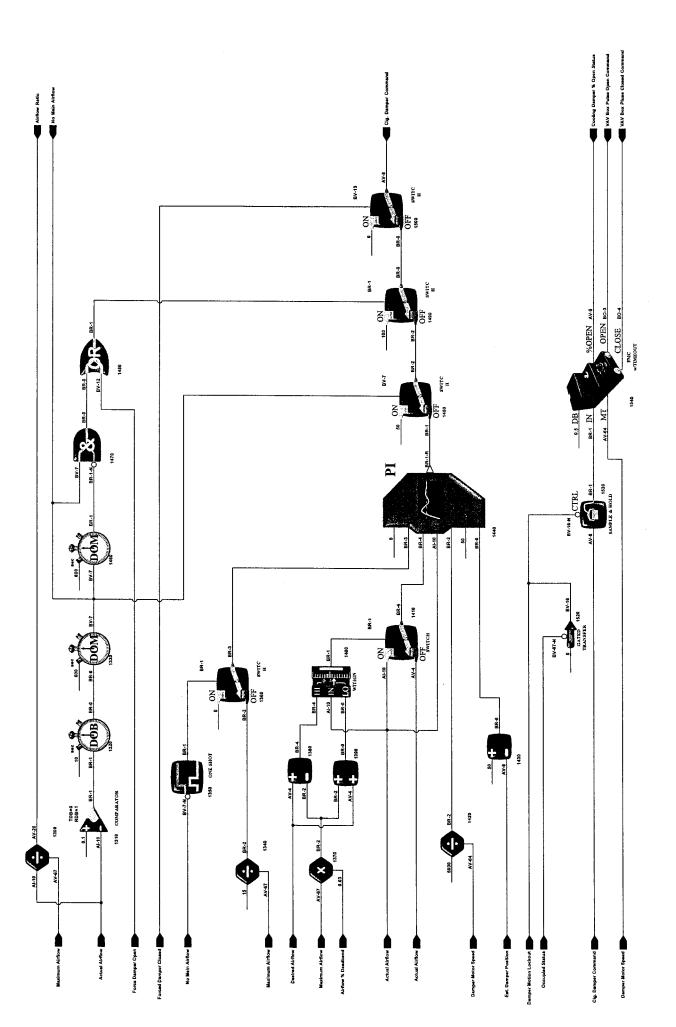


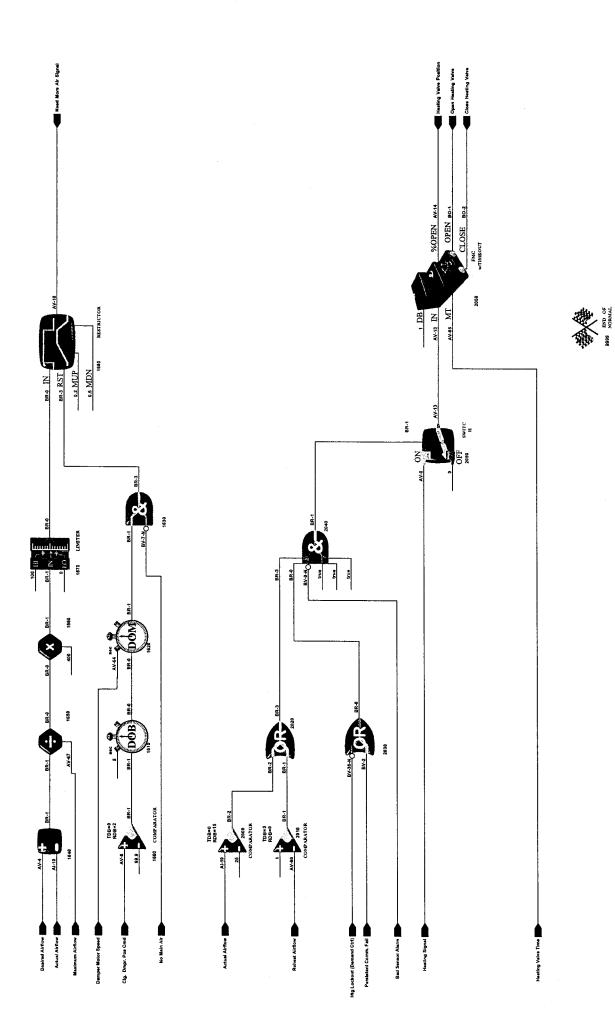



ווחחחח חבבה ב

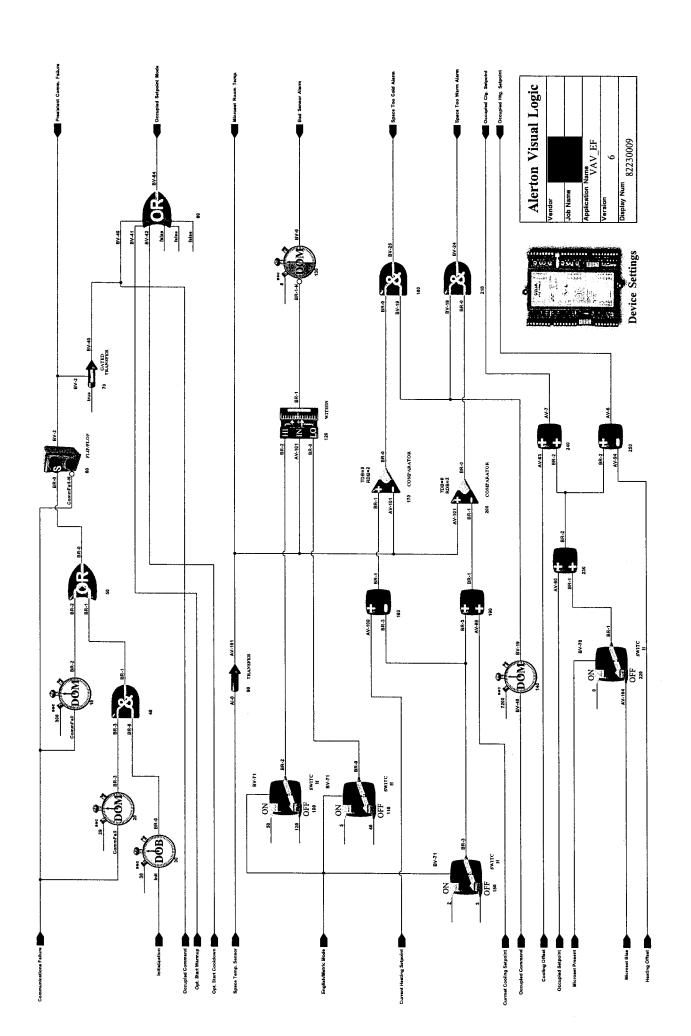


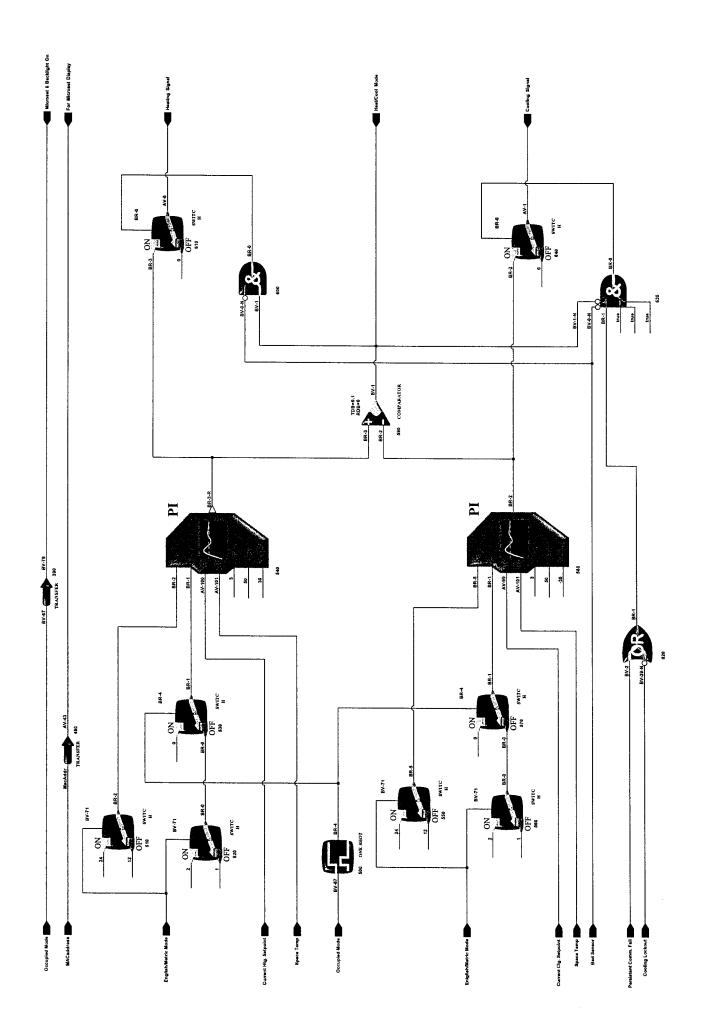

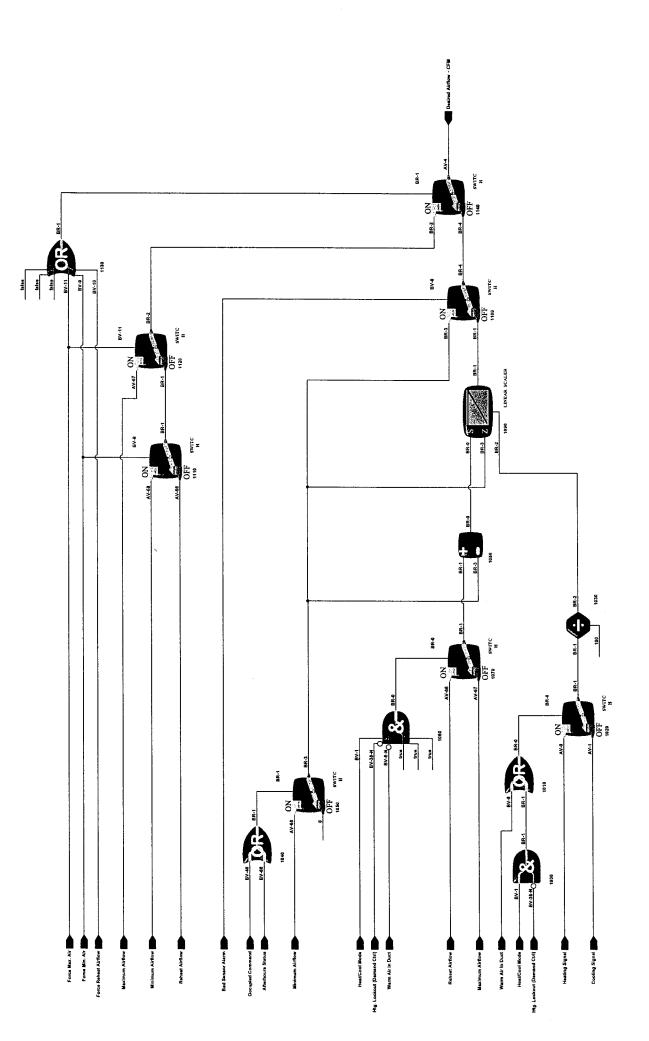

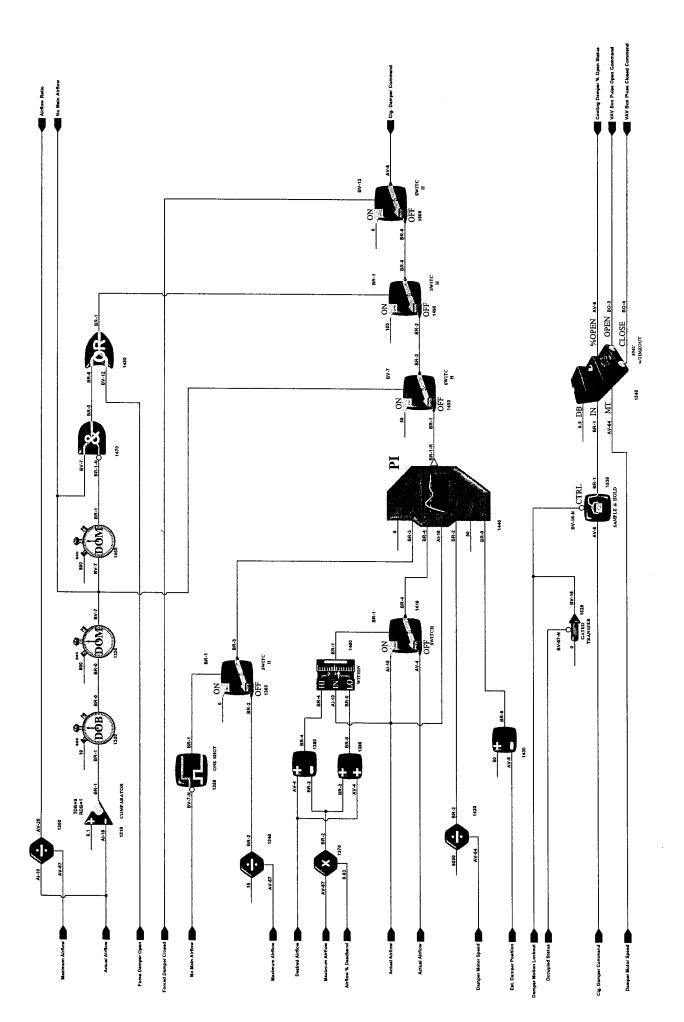

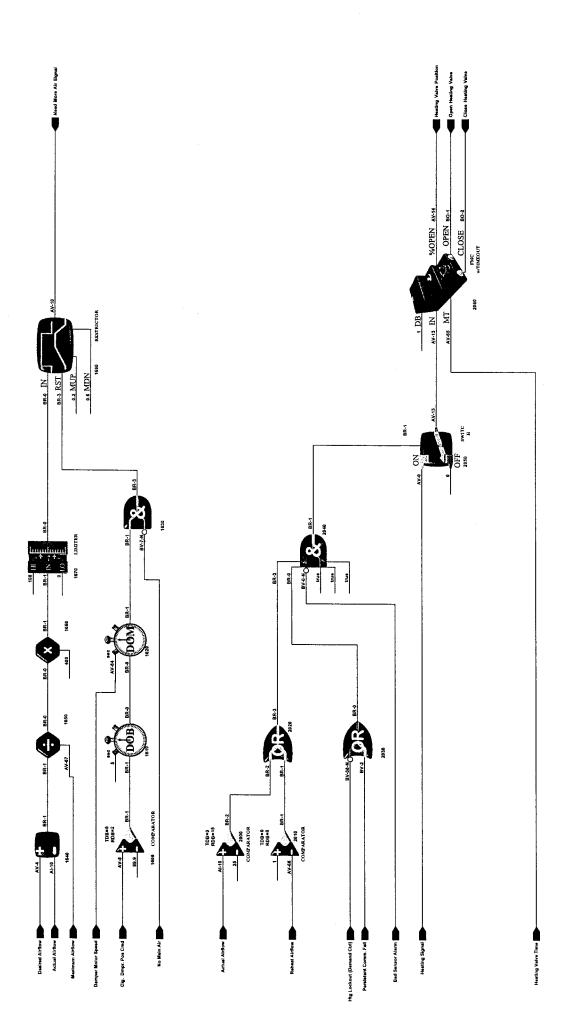

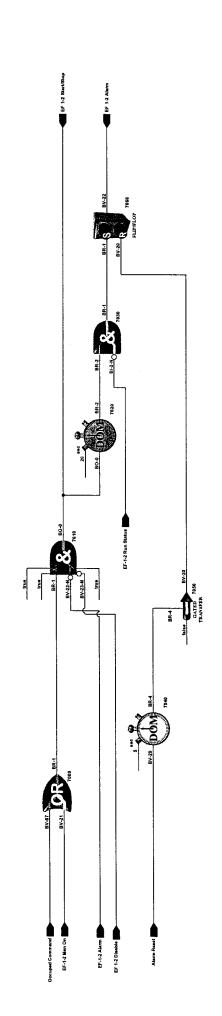



WAW EE Dana R